


15233
VENTURA

VALLEY OFFICE PLAZA

SUITE 250 | 5,047 RSF

SHERMAN OAKS/ENCINO

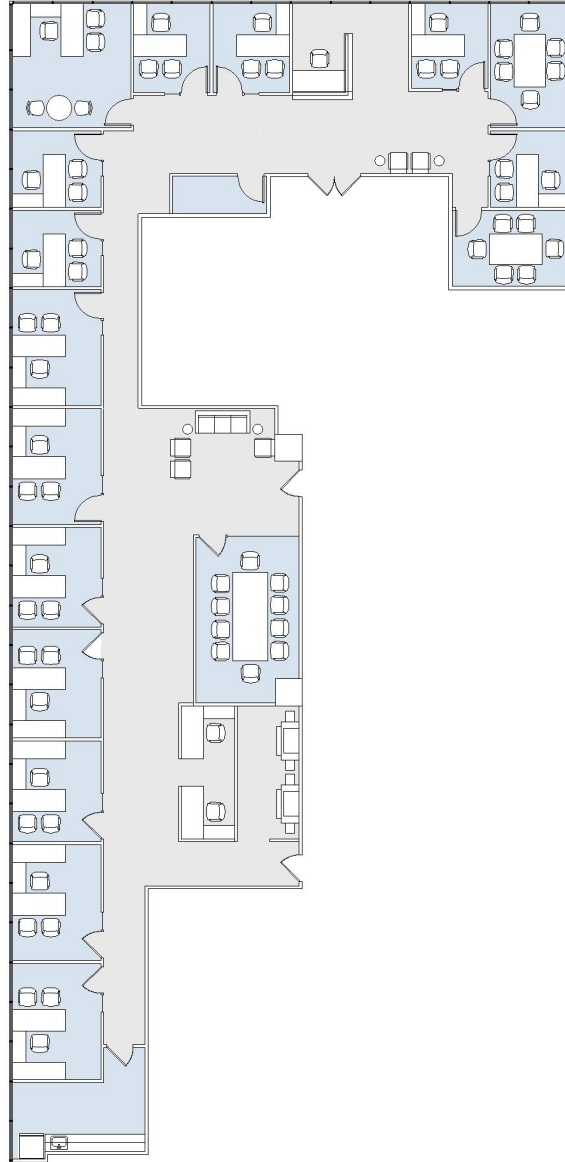


AS-BUILT CONFIGURATION

OFFICES:	14
CONFERENCE ROOM:	3
RECEPTION:	1
KITCHEN:	1
COPY ROOM:	1
STORAGE:	1

NOT TO SCALE

FURNITURE NOT INCLUDED

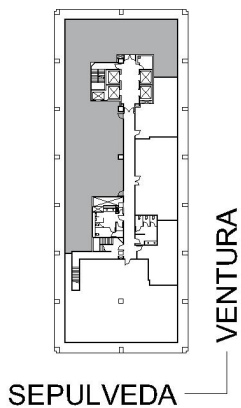

For more information, please contact:

310.255.7777
leasing@douglasemmett.com

**Douglas
Emmett**