
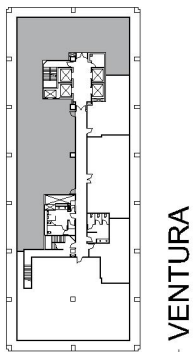


# 15233 VENTURA

VALLEY OFFICE PLAZA

SUITE 250 | 5,047 RSF

SHERMAN OAKS/ENCINO

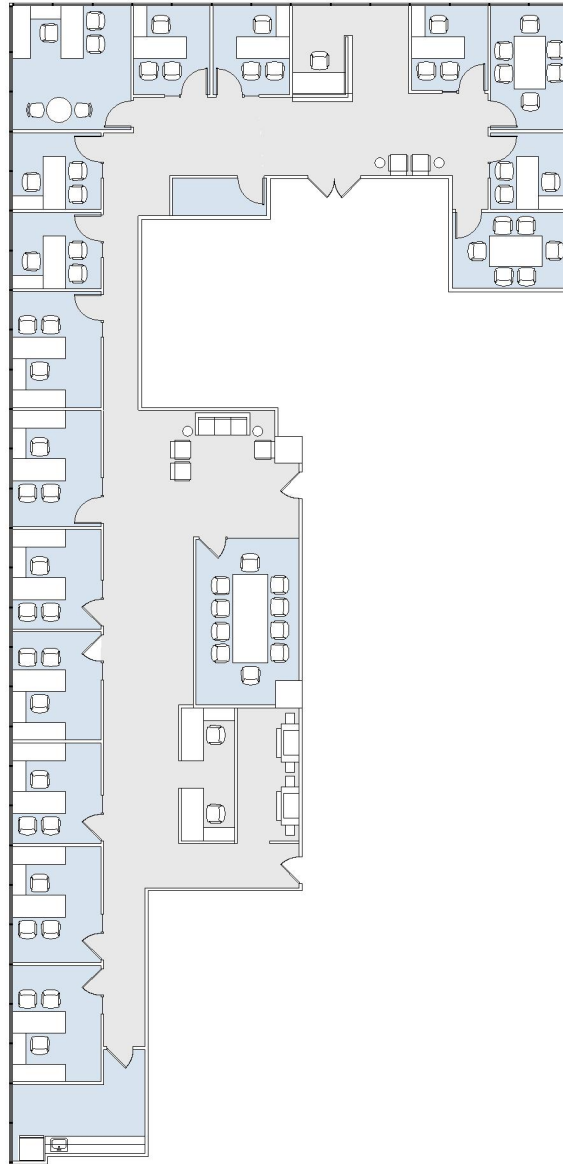

#### AS-BUILT CONFIGURATION

OFFICES:	14
CONFERENCE ROOM:	3
RECEPTION:	1
KITCHEN:	1
COPY ROOM:	1
STORAGE:	1

NOT TO SCALE

FURNITURE NOT INCLUDED

For more information, please contact:

310.255.7777

leasing@douglasemmett.com

**Douglas  
Emmett**