

15821 VENTURA

ENCINO TERRACE

SUITE 260 | 2,867 RSF

SHERMAN OAKS/ENCINO




AS-BUILT CONFIGURATION

OFFICES:	3
CONFERENCE ROOM:	1
RECEPTION:	1
IT ROOM:	1
FILE ROOM:	1

NOT TO SCALE

FURNITURE NOT INCLUDED

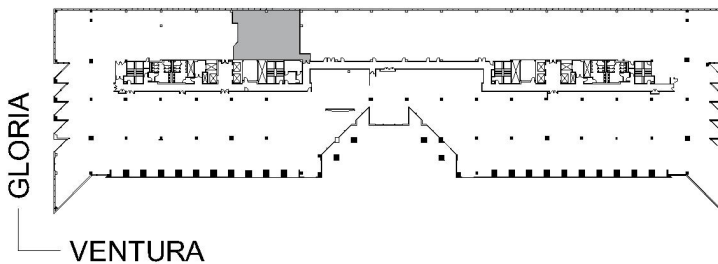

For more information, please contact:

310.255.7777

leasing@douglasemmett.com

**Douglas
Emmett**