



15821

ENCINO TERRACE

SUITE 260 | 2,867 RSF

SHERMAN OAKS/ENCINO

# VENTURA

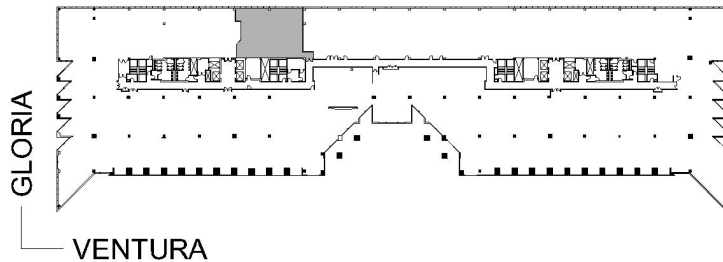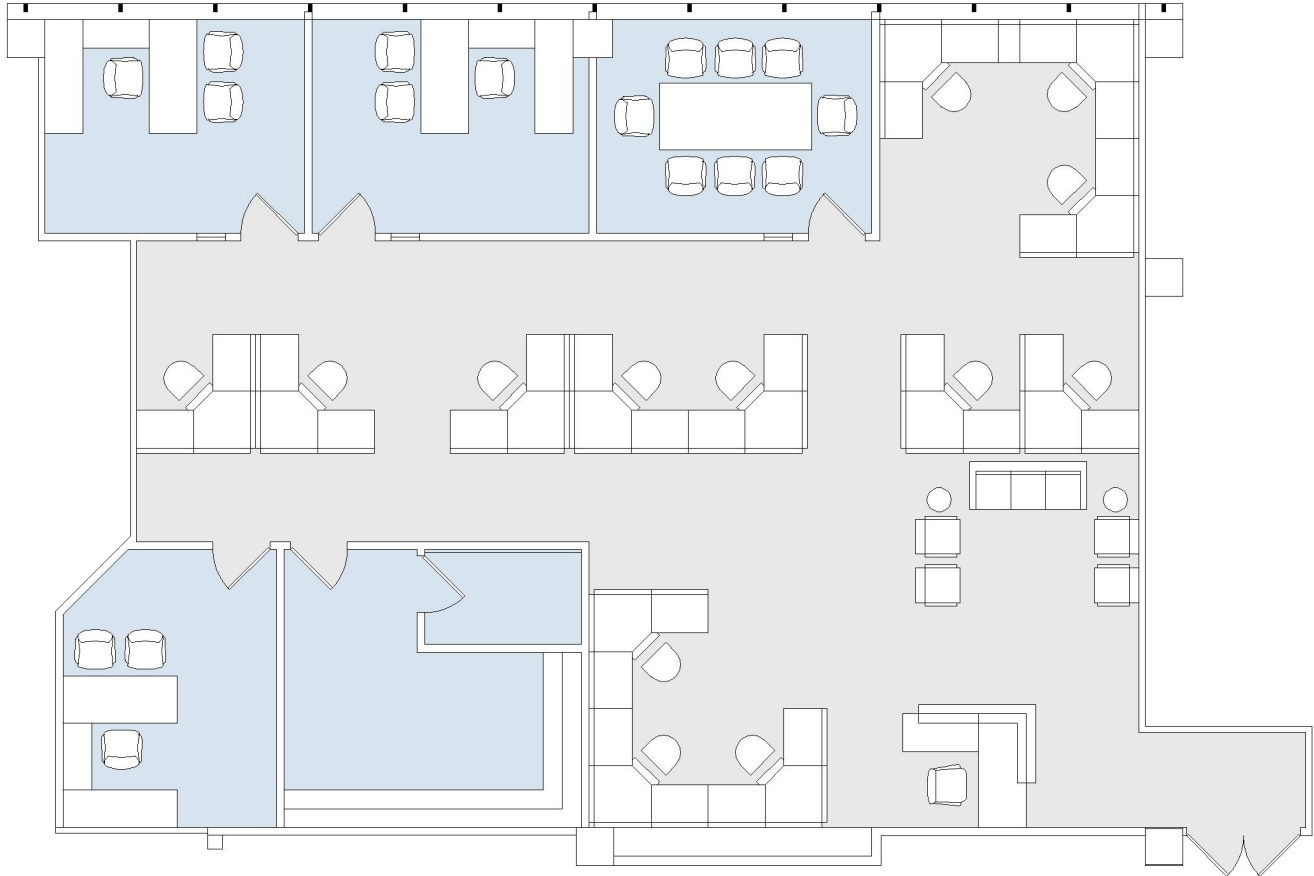

### AS-BUILT CONFIGURATION

OFFICES:	3
CONFERENCE ROOM:	1
RECEPTION:	1
IT ROOM:	1
FILE ROOM:	1

NOT TO SCALE  
FURNITURE NOT INCLUDED

For more information, please contact:

310.255.7777  
leasing@douglasemmett.com

**Douglas  
Emmett**