



# 55

HARBOR COURT - OFFICE

SUITE 1430 | 5,126 RSF

HONOLULU

## MERCHANT STREET

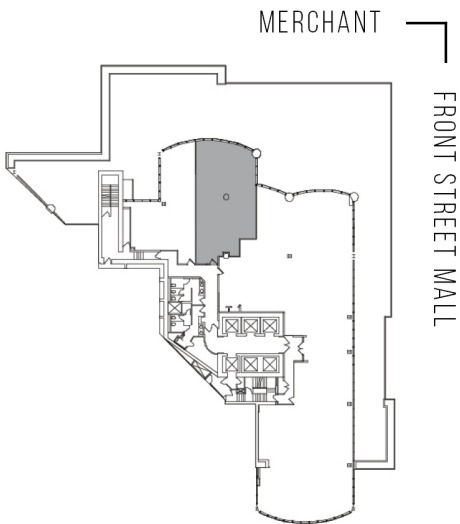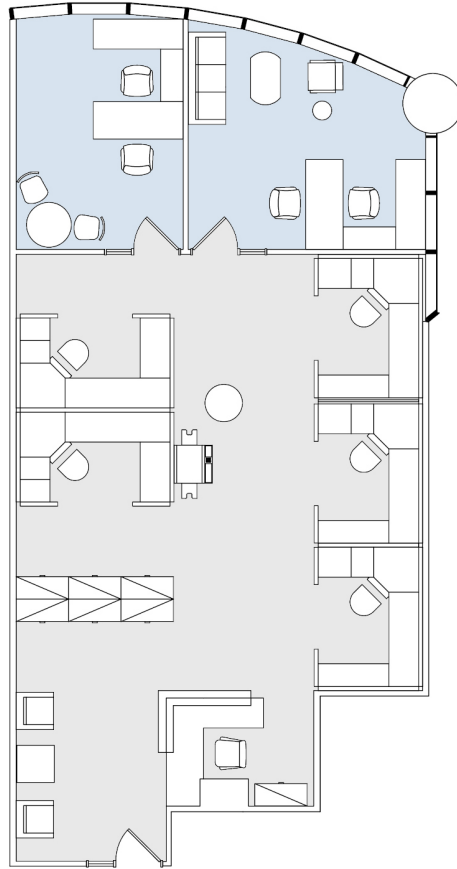

### AS-BUILT CONFIGURATION

OFFICES:	2
RECEPTION:	1
WORKSTATIONS:	5

ADJUSTED FOR SOCIAL DISTANCING

NOT TO SCALE  
FURNITURE NOT INCLUDED

For more information, please contact:

310.255.7777

leasing@douglasemmett.com

**Douglas  
Emmett**