
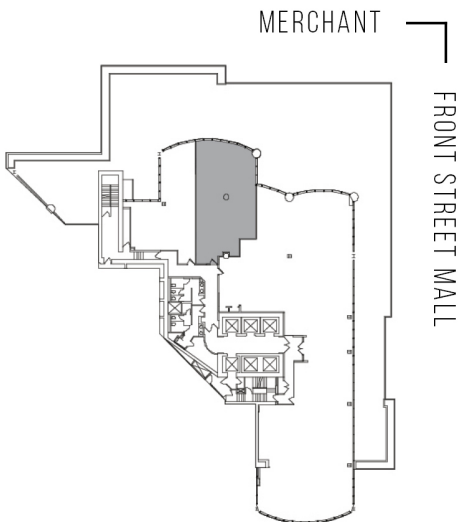


MERCHANT STREET

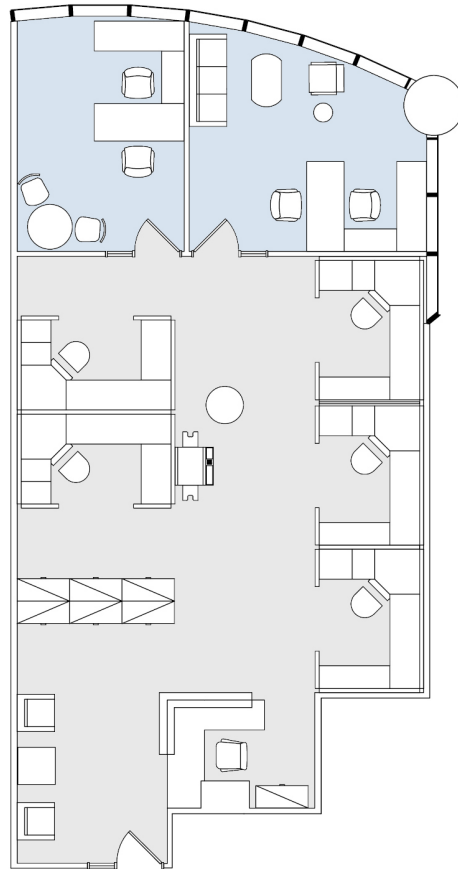

AS-BUILT CONFIGURATION

OFFICES:	2
RECEPTION:	1
WORKSTATIONS:	5

ADJUSTED FOR SOCIAL DISTANCING

NOT TO SCALE
FURNITURE NOT INCLUDED

For more information, please contact:

310.255.7777
leasing@douglasemmett.com

