
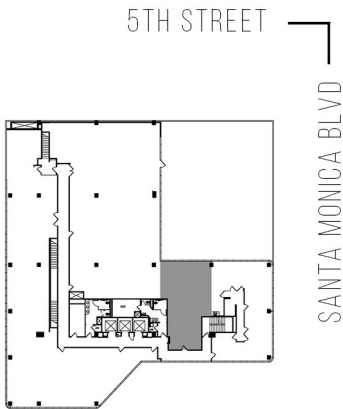


# 429

SUITE 210 | 1,395 RSF

SANTA MONICA

## SANTA MONICA

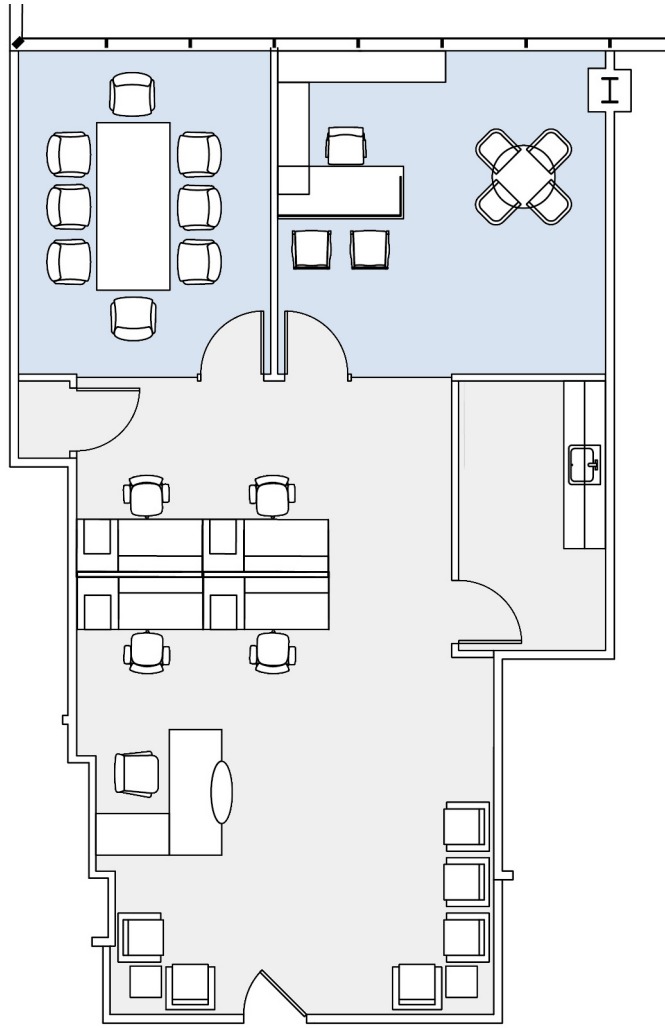

### AS-BUILT CONFIGURATION

OFFICE:	1
RECEPTION:	1
CONFERENCE ROOM:	1
CLOSET:	1

NOT TO SCALE  
FURNITURE NOT INCLUDED

For more information, please contact:

310.255.7777

leasing@douglasemmett.com

**Douglas  
Emmett**