
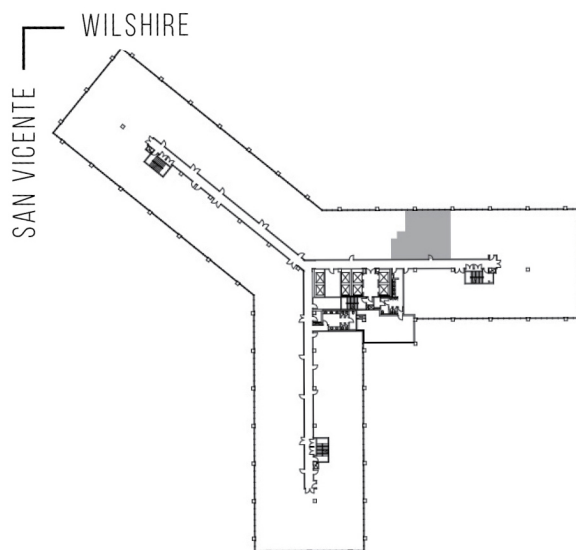


# 8383 WILSHIRE

SUITE 214 | 1,462 RSF  
BEVERLY HILLS

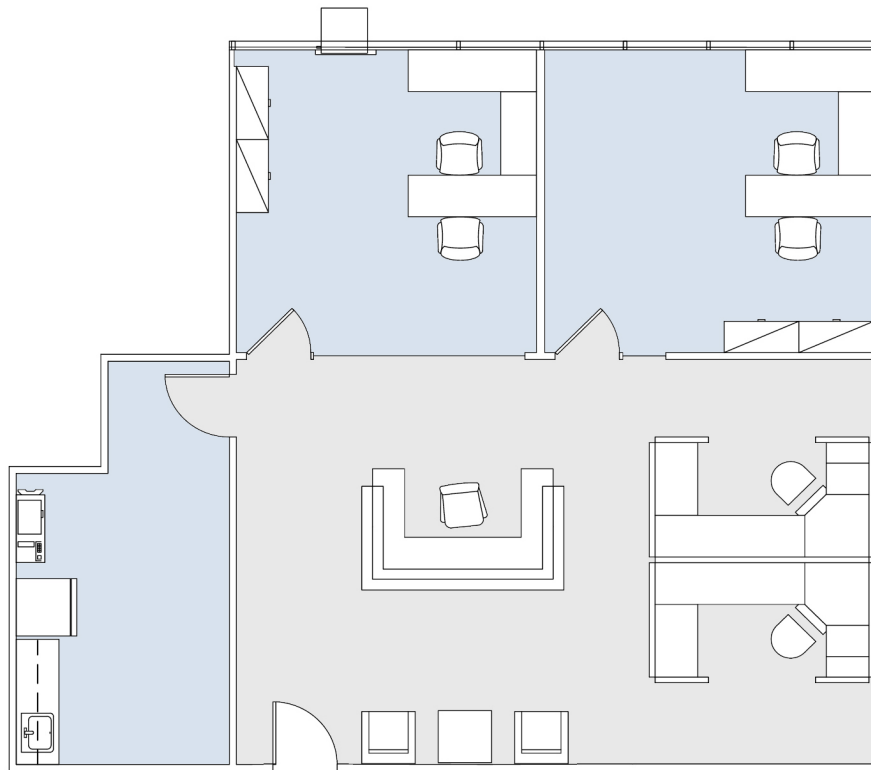

#### AS-BUILT CONFIGURATION

OFFICES:	2
WORKSTATIONS:	2
RECEPTION:	1
KITCHEN:	1

ADJUSTED FOR SOCIAL DISTANCING  
NOT TO SCALE  
FURNITURE NOT INCLUDED

For more information, please contact:

310.255.7777  
leasing@douglasemmett.com

**Douglas  
Emmett**