
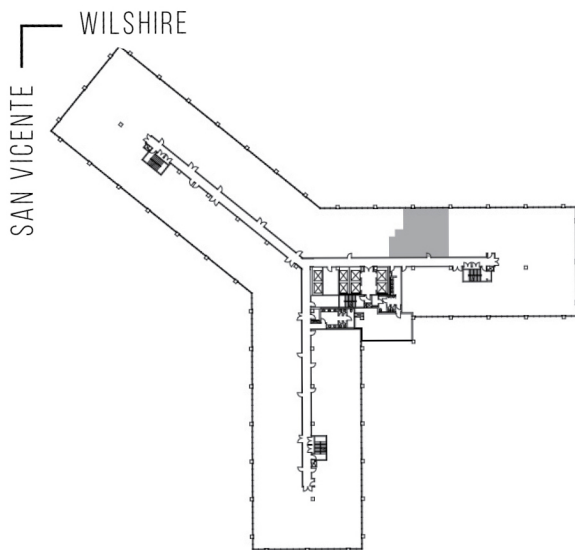


8383

WILSHIRE

SUITE 214 | 1,462 RSF

BEVERLY HILLS

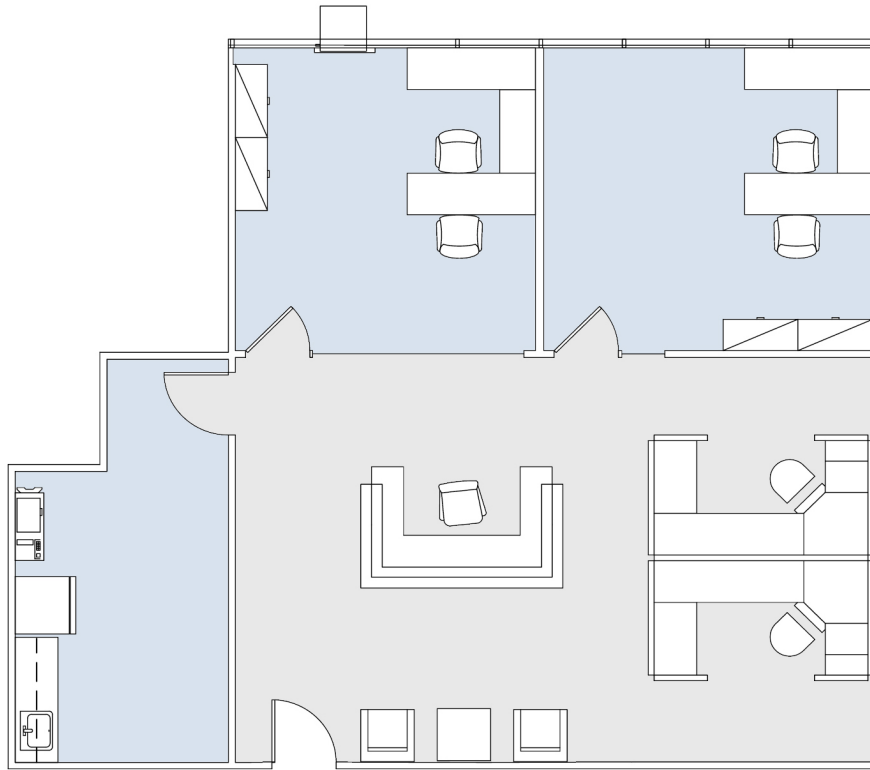

AS-BUILT CONFIGURATION

|               |   |
|---------------|---|
| OFFICES:      | 2 |
| WORKSTATIONS: | 2 |
| RECEPTION:    | 1 |
| KITCHEN:      | 1 |

ADJUSTED FOR SOCIAL DISTANCING  
NOT TO SCALE  
FURNITURE NOT INCLUDED

For more information, please contact:

310.255.7777  
leasing@douglasemmett.com

**Douglas  
Emmett**