


11766 WILSHIRE

LANDMARK II

SUITE 100 | 6,199 RSF
BRENTWOOD-WILSHIRE

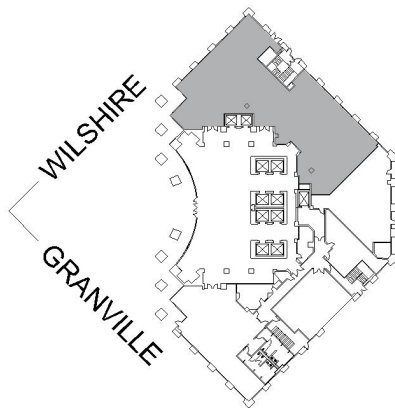

AS-BUILT CONFIGURATION

OFFICES:	3
CONFERENCE ROOM:	1
RECEPTION:	1
KITCHEN:	1
PRIVATE BATHROOM:	2
BANK VAULT:	1

NOT TO SCALE
FURNITURE NOT INCLUDED

For more information, please contact:

310.255.7777
leasing@douglasemmett.com

**Douglas
Emmett**