

BRENTWOOD-WILSHIRE

## **WILSHIRE**

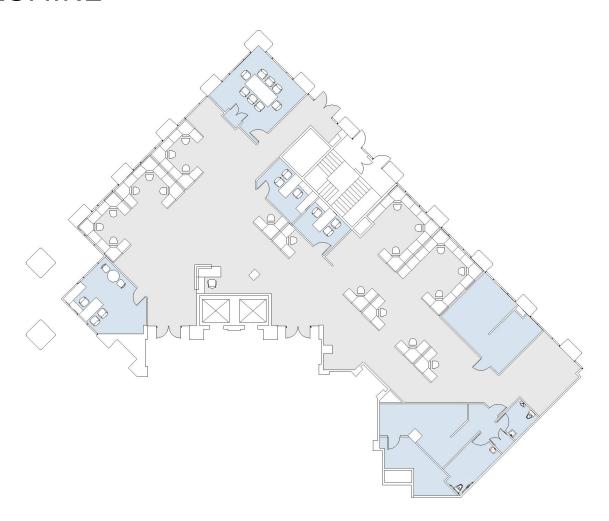

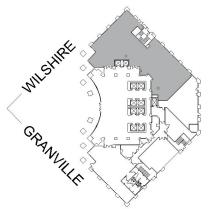

## AS-BUILT CONFIGURATION

OFFICES:	3
CONFERENCE ROOM:	1
RECEPTION:	1
KITCHEN:	1
PRIVATE BATHROOM:	2
BANK VAULT:	1

NOT TO SCALE FURNITURE NOT INCLUDED

For more information, please contact:

