
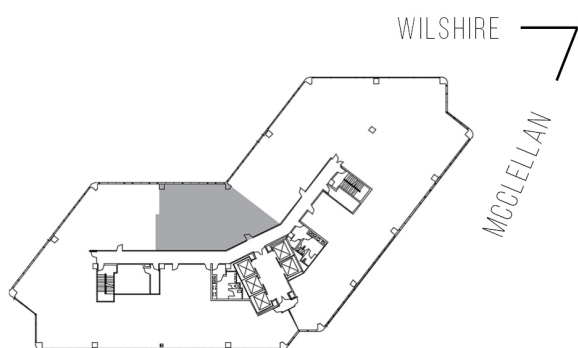


12400 WILSHIRE

SUITE 995 | 1,850 RSF

BRENTWOOD-WILSHIRE

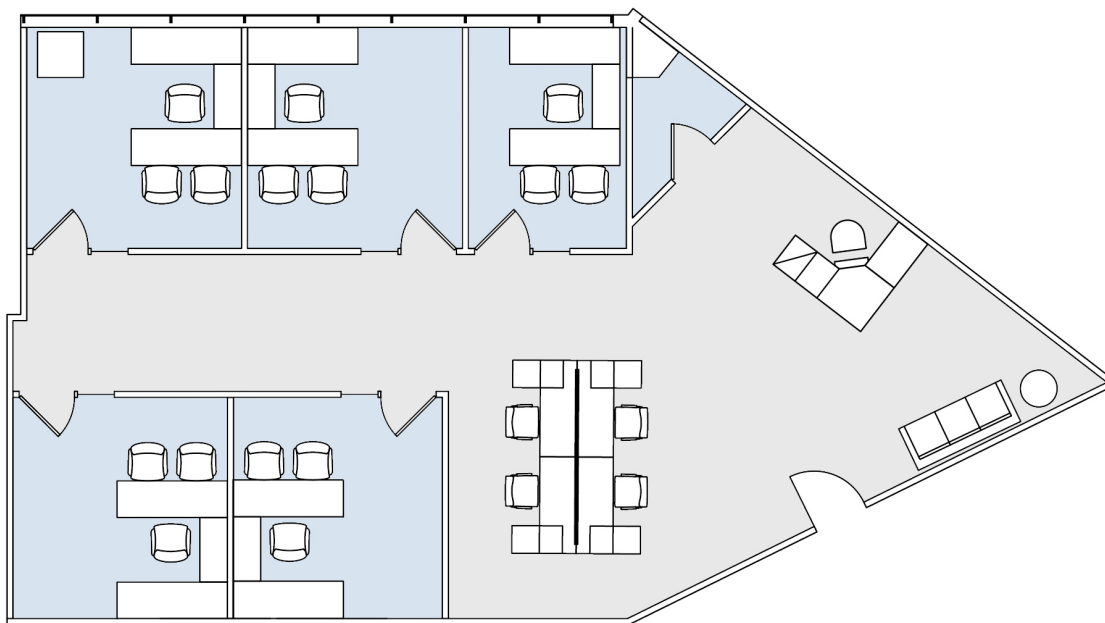

AS-BUILT CONFIGURATION

OFFICES:	5
RECEPTION:	1
STORAGE CLOSET:	1

NOT TO SCALE

For more information, please contact:

310.255.7777
leasing@douglasemmett.com

**Douglas
Emmett**