



# 11980

BRENTWOOD MEDICAL PLAZA

SUITE 607 | 1,863 RSF

BRENTWOOD-SAN VICENTE

## SAN VICENTE

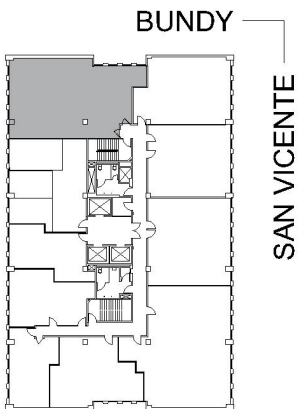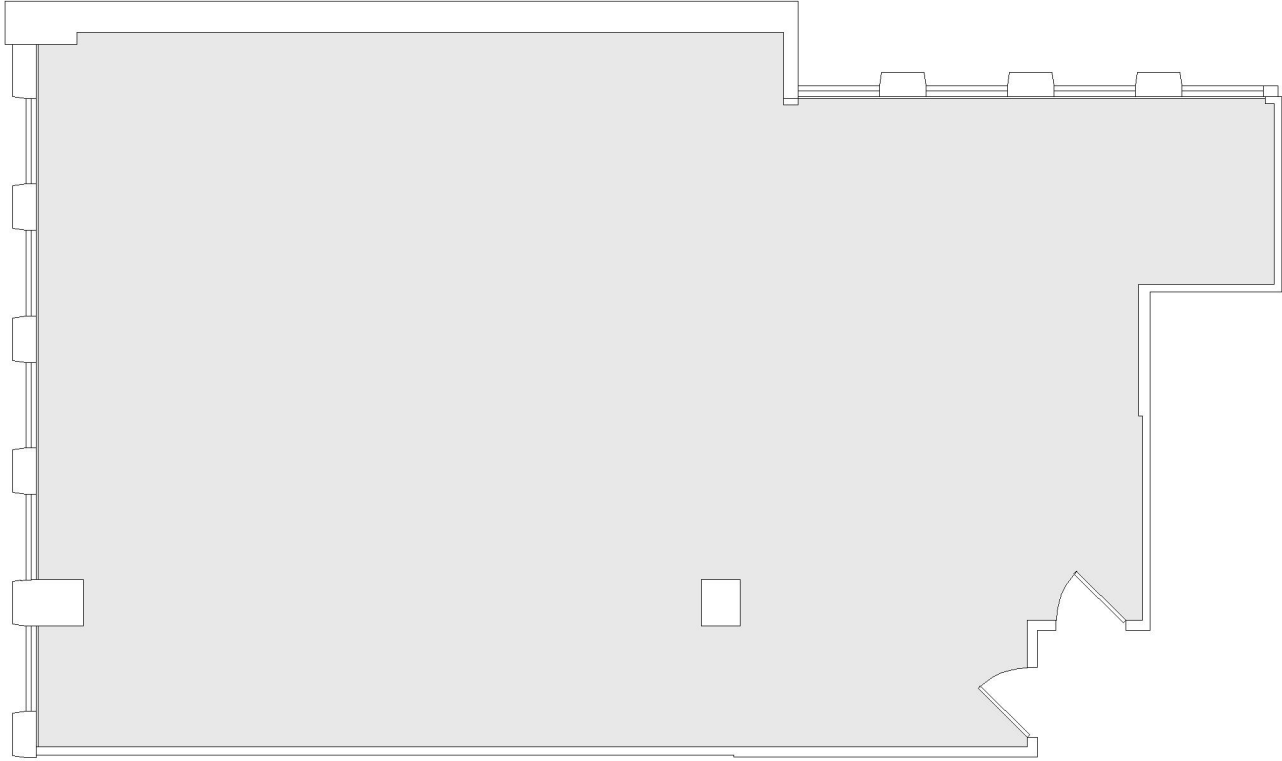

AS-BUILT CONFIGURATION

SHELL SPACE

NOT TO SCALE

For more information, please contact:

310.255.7777

leasing@douglasemmett.com

**Douglas  
Emmett**