
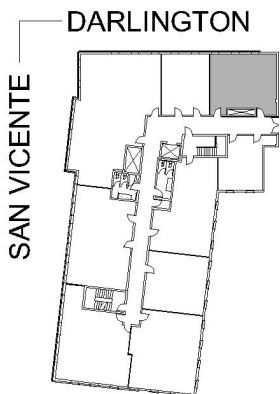


11633

BRENTWOOD SAN VICENTE MEDICAL SOUTH SUITE 200 | 770 RSF

BRENTWOOD-SAN VICENTE

SAN VICENTE

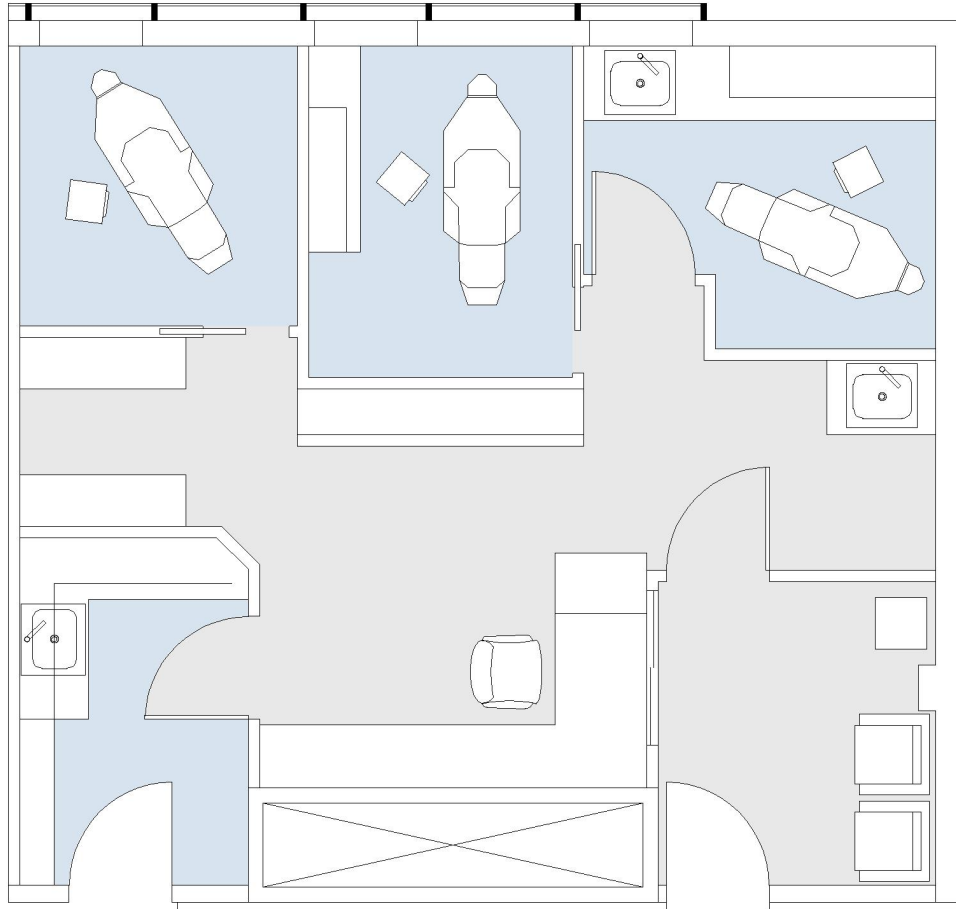

AS-BUILT CONFIGURATION MEDICAL SUITE

EXAM ROOM:	3
RECEPTION:	1
KITCHEN:	1

NOT TO SCALE

FURNITURE NOT INCLUDED

For more information, please contact:

310.255.7777

leasing@douglasemmett.com

**Douglas
Emmett**