
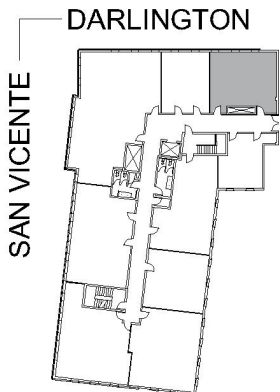


# 11633

BRENTWOOD SAN VICENTE MEDICAL SOUTH SUITE 200 | 770 RSF

BRENTWOOD-SAN VICENTE

## SAN VICENTE

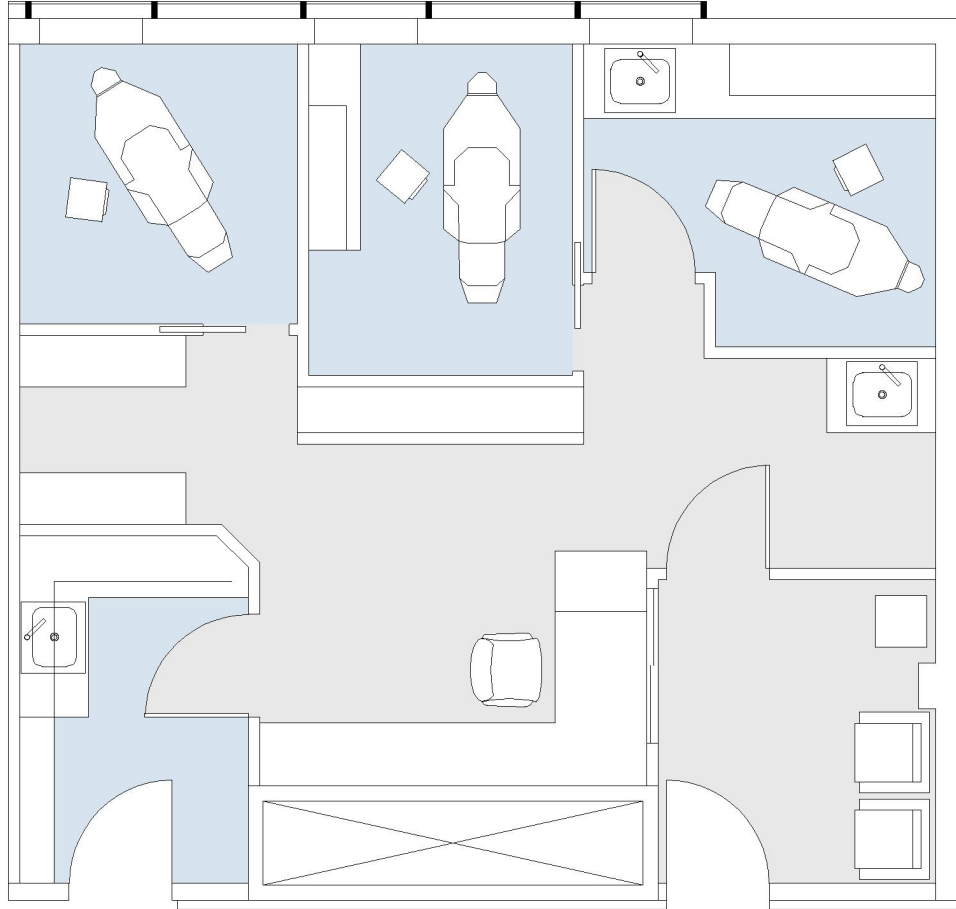

**AS-BUILT CONFIGURATION  
MEDICAL SUITE**

EXAM ROOM:	3
RECEPTION:	1
KITCHEN:	1

NOT TO SCALE

FURNITURE NOT INCLUDED

For more information, please contact:

310.255.7777

leasing@douglasemmett.com

