
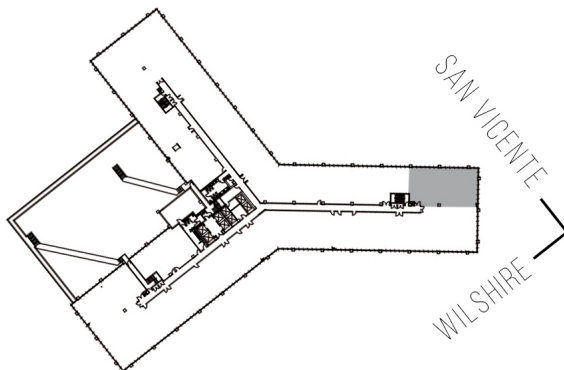


# 8383 WILSHIRE

SUITE 230 | 2,597 RSF

BEVERLY HILLS

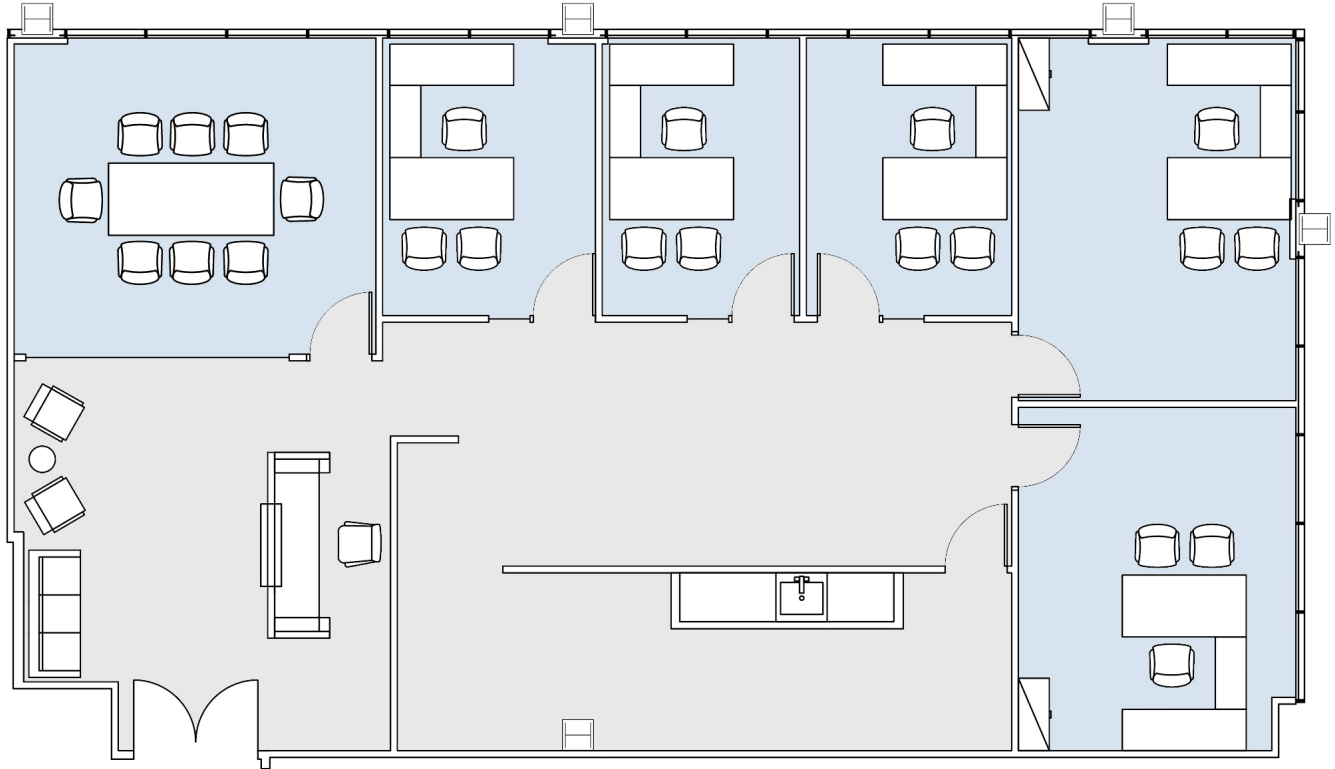

## AS-BUILT CONFIGURATION

OFFICES:	5
RECEPTION:	1
KITCHEN:	1
CONFERENCE ROOM:	1

NOT TO SCALE  
FURNITURE NOT INCLUDED

For more information, please contact:

310.255.7777  
leasing@douglasemmett.com

**Douglas  
Emmett**