
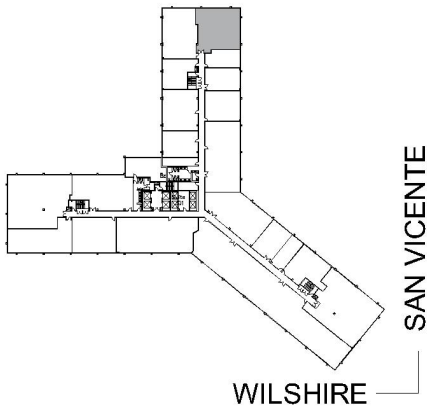


8383

# WILSHIRE

SUITE 350 | 2,147 RSF

BEVERLY HILLS

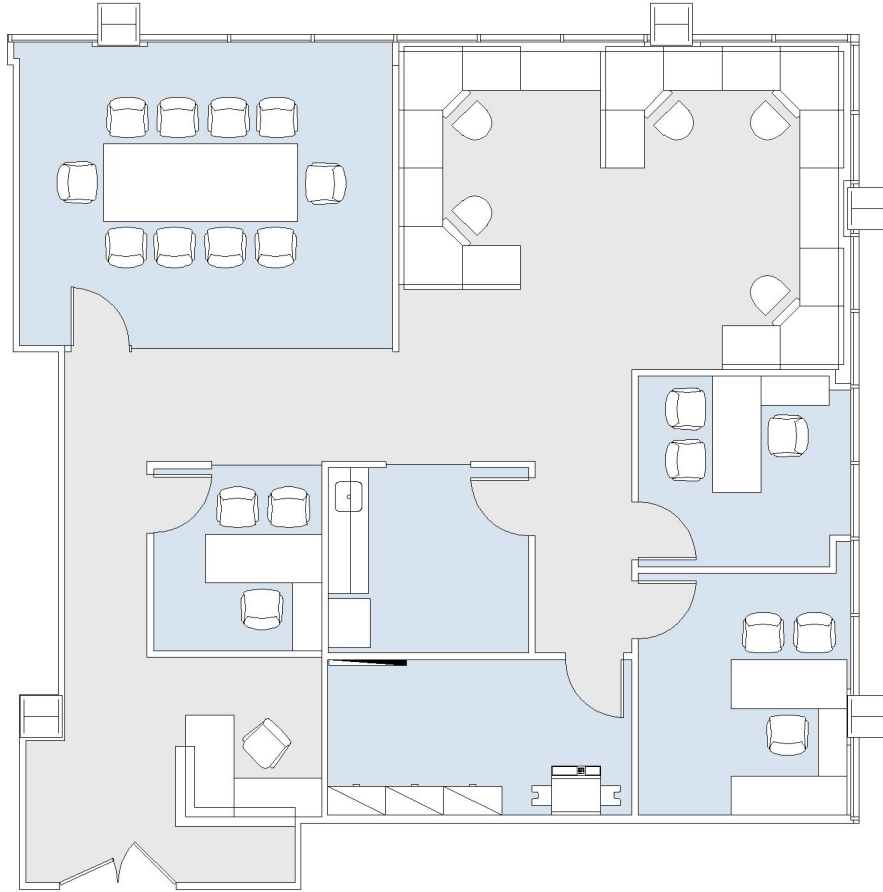

### AS-BUILT CONFIGURATION

OFFICES:	3
CONFERENCE ROOM:	1
RECEPTION:	1
KITCHEN:	1
IT/STORAGE ROOM:	1

NOT TO SCALE

FURNITURE NOT INCLUDED

For more information, please contact:

310.255.7777  
leasing@douglasemmett.com

**Douglas  
Emmett**