



6310

CARTHAY CAMPUS 10

SUITE 320 | 3,917 RSF

BEVERLY HILLS

SAN VICENTE

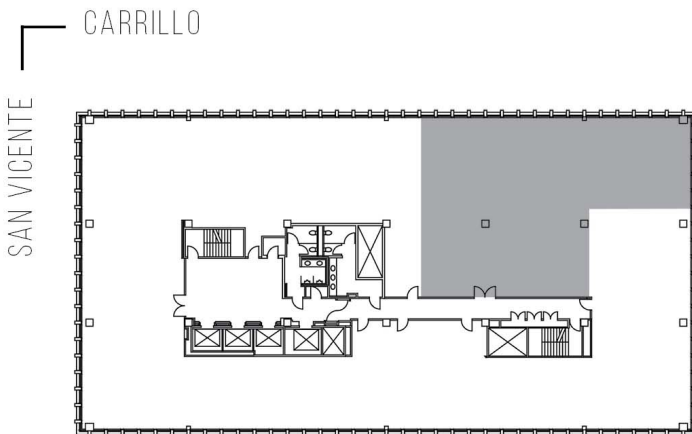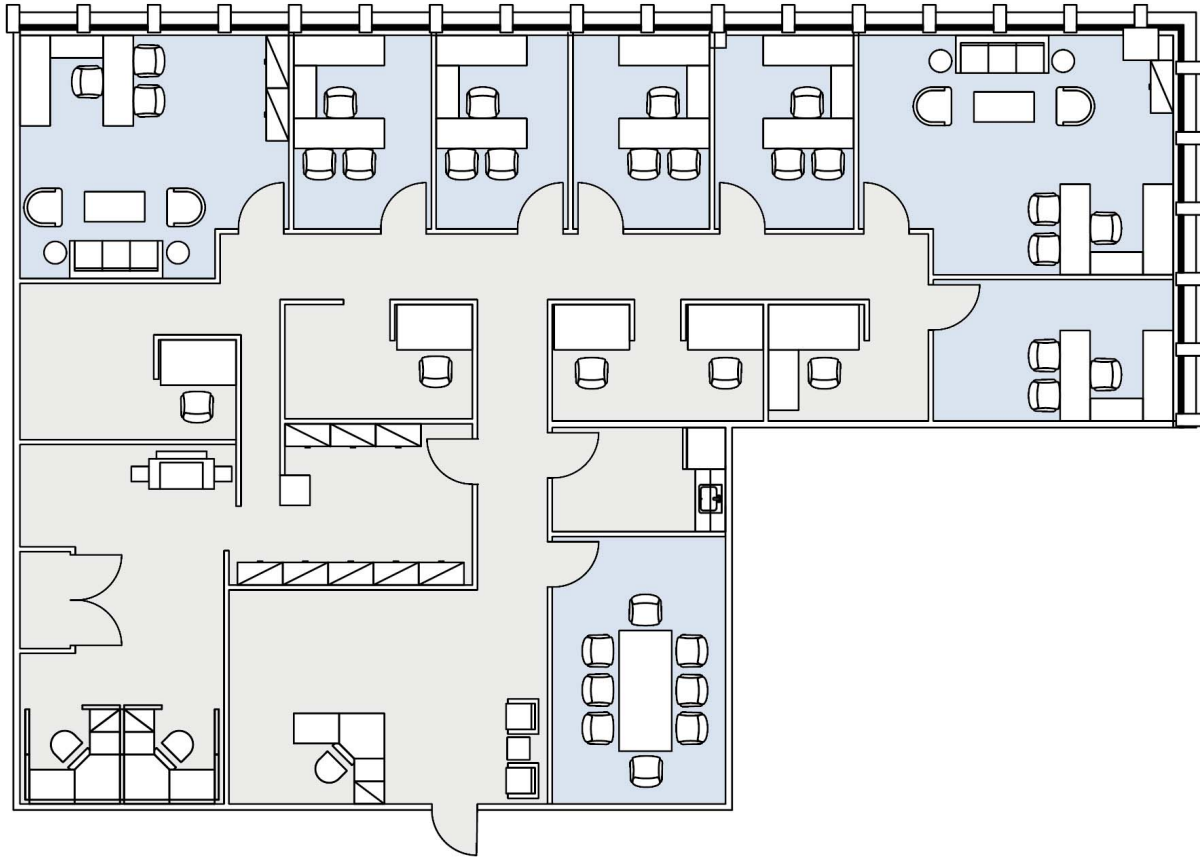

AS-BUILT CONFIGURATION

OFFICES:	7
RECEPTION AREA:	1
CONFERENCE ROOM:	1
FILE ROOM:	1
KITCHEN:	1
IT ROOM:	1

NOT TO SCALE
FURNITURE NOT INCLUDED

For more information, please contact:

310.255.7777

leasing@douglasemmett.com

**Douglas
Emmett**