
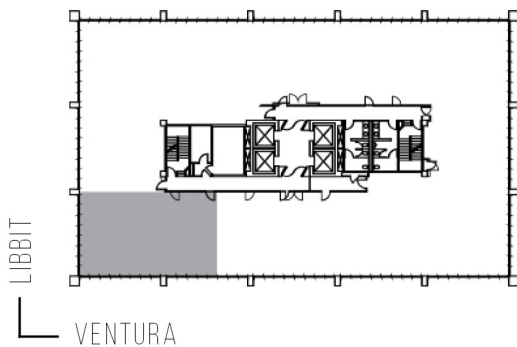


# 16255 VENTURA

MB PLAZA

SUITE 707 | 1,840 RSF

SHERMAN OAKS/ENCINO

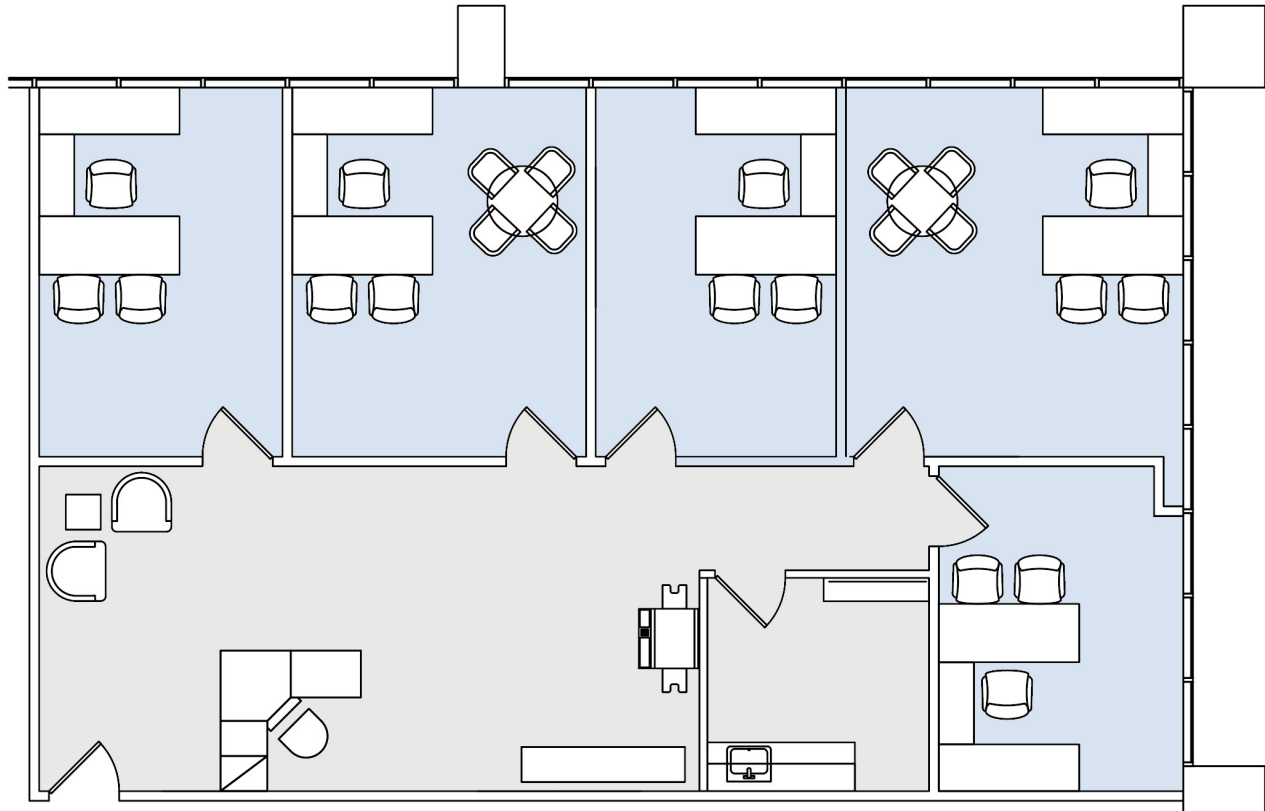

## AS-BUILT CONFIGURATION

OFFICES:	5
KITCHEN:	1
RECEPTION AREA:	1

NOT TO SCALE  
FURNITURE NOT INCLUDED

For more information, please contact:

310.255.7777

leasing@douglasemmett.com

**Douglas  
Emmett**