


# 1901 AVENUE OF THE STARS

SUITE 935 | 3,834 RSF

CENTURY CITY

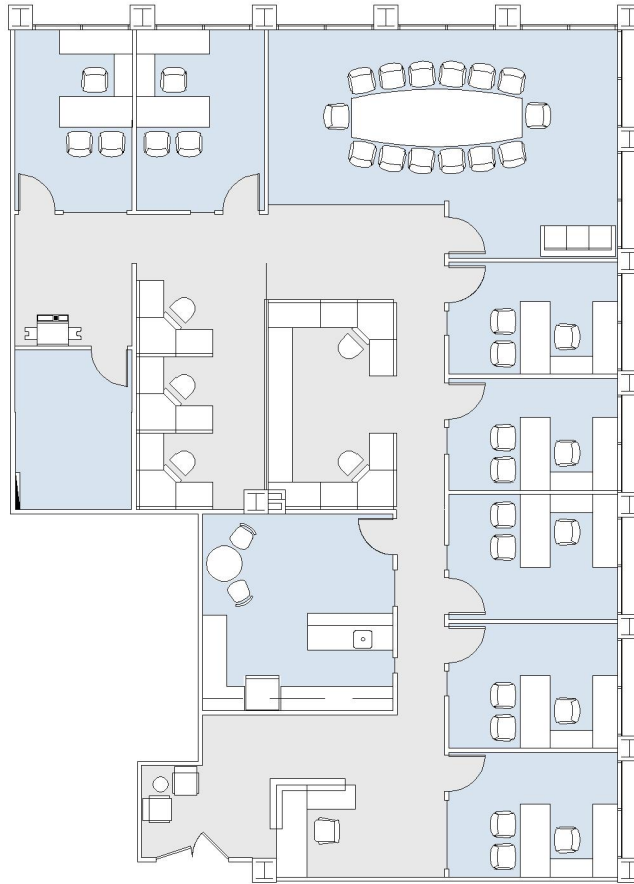


#### AS-BUILT CONFIGURATION

OFFICES:	7
CONFERENCE ROOM:	1
RECEPTION:	1
KITCHEN:	1
IT ROOM:	1

NOT TO SCALE

FURNITURE NOT INCLUDED

AVE OF THE STARS

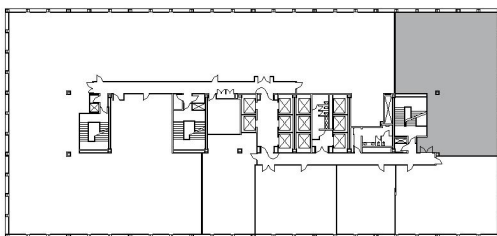

SANTA MONICA

For more information, please contact:

310.255.7777

leasing@douglasemmett.com

**Douglas  
Emmett**