


1901 AVENUE OF THE STARS

SUITE 935 | 3,834 RSF

CENTURY CITY

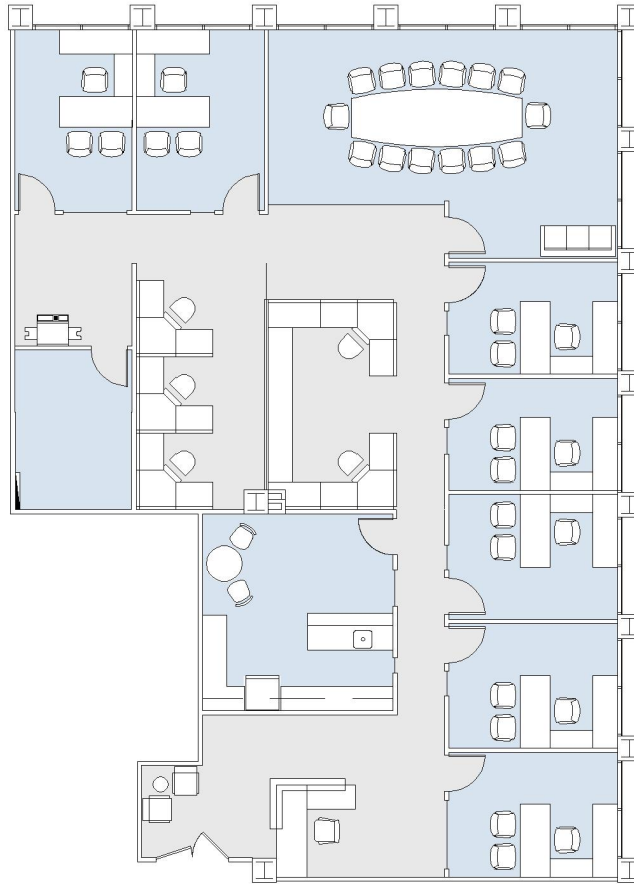


AS-BUILT CONFIGURATION

| | |
|------------------|---|
| OFFICES: | 7 |
| CONFERENCE ROOM: | 1 |
| RECEPTION: | 1 |
| KITCHEN: | 1 |
| IT ROOM: | 1 |

NOT TO SCALE

FURNITURE NOT INCLUDED

AVE OF THE STARS

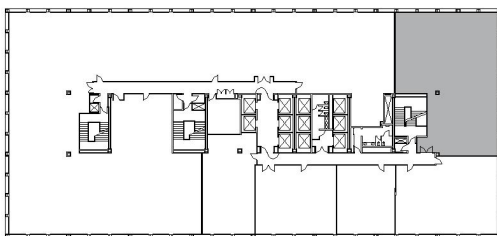

SANTA MONICA

For more information, please contact:

310.255.7777

leasing@douglasemmett.com

**Douglas
Emmett**