



21600

WARNER CENTER TOWER - I

SUITE 1760 | 3,319 RSF

WOODLAND HILLS

OXNARD STREET

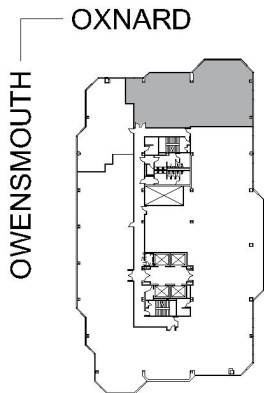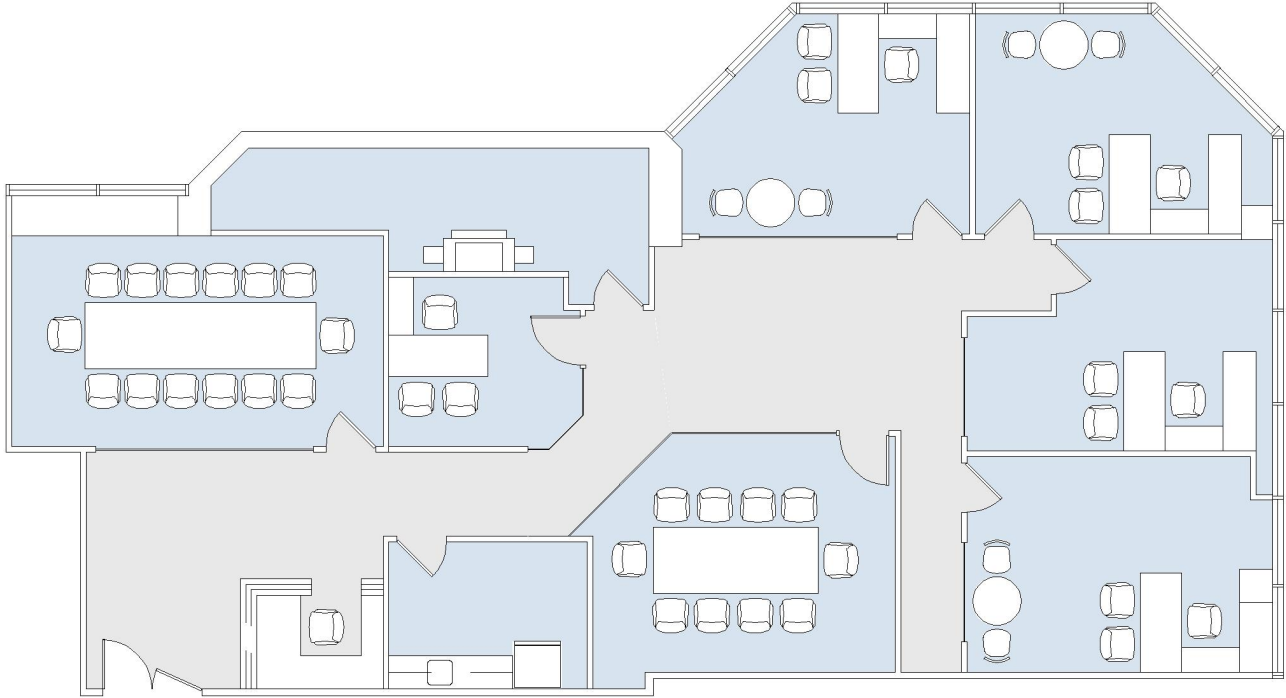

AS-BUILT CONFIGURATION

OFFICES:	4
CONFERENCE ROOM:	2
RECEPTION:	1
KITCHEN:	1
STORAGE / IT ROOM:	1

NOT TO SCALE
FURNITURE NOT INCLUDED

For more information, please contact:

310.255.7777
leasing@douglasemmett.com

**Douglas
Emmett**