
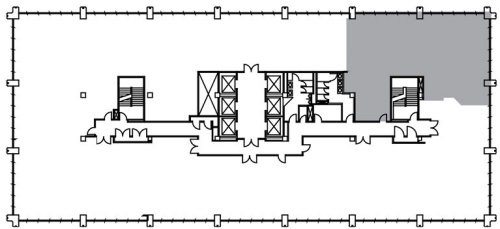


# 15760 VENTURA

ENCINO GATEWAY

SUITE 880 | 2,779 RSF

SHERMAN OAKS/ENCINO

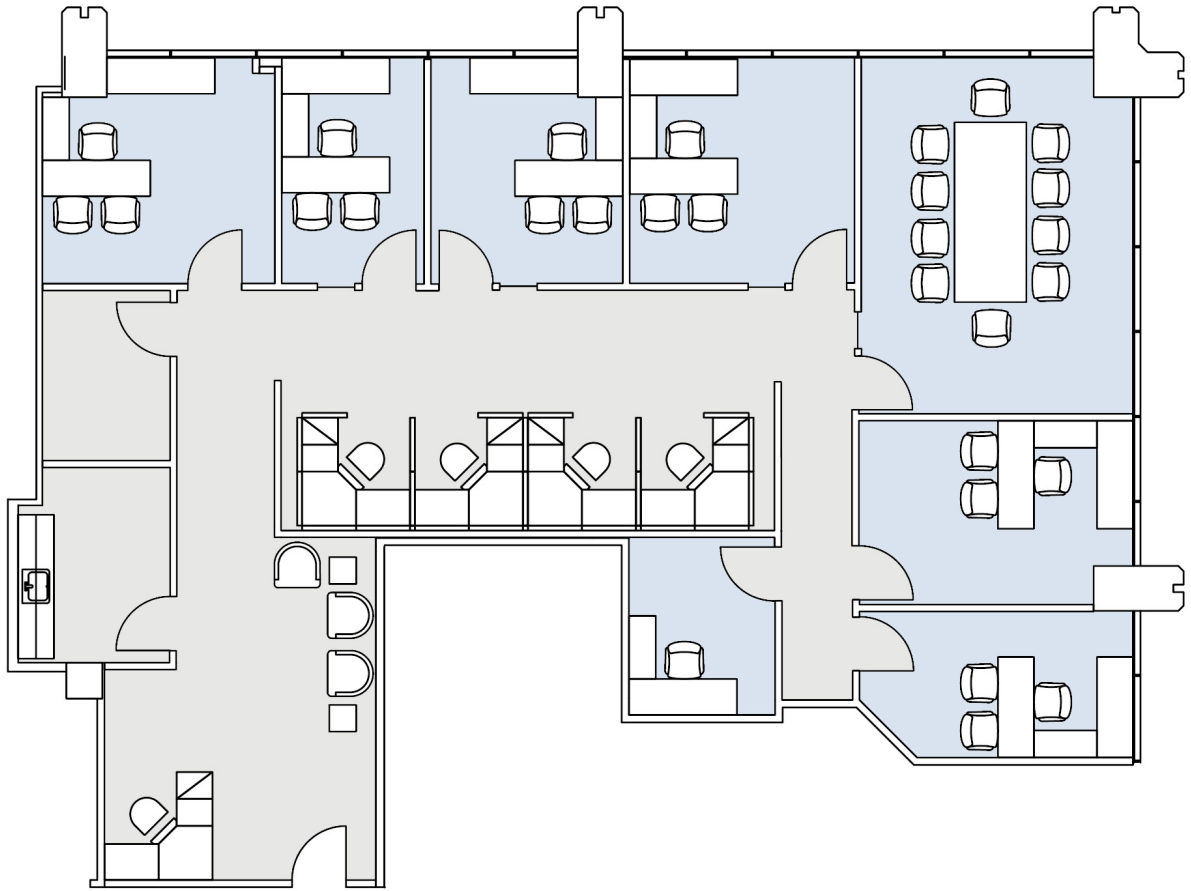

DENMORE AVE

VENTURA BLVD

## AS-BUILT CONFIGURATION

OFFICES:	7
RECEPTION:	1
CONFERENCE ROOM:	1
KITCHEN:	1
STORAGE:	1

NOT TO SCALE  
FURNITURE NOT INCLUDED

For more information, please contact:

310.255.7777

leasing@douglasemmett.com

**Douglas  
Emmett**