
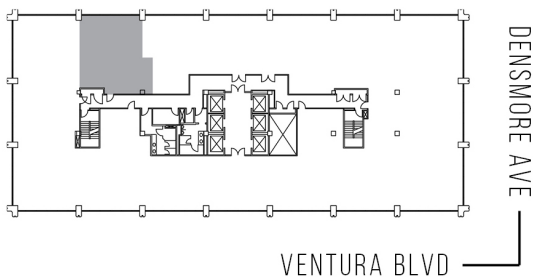


15760 VENTURA

ENCINO GATEWAY

SUITE 1560 | 1,261 RSF

SHERMAN OAKS/ENCINO

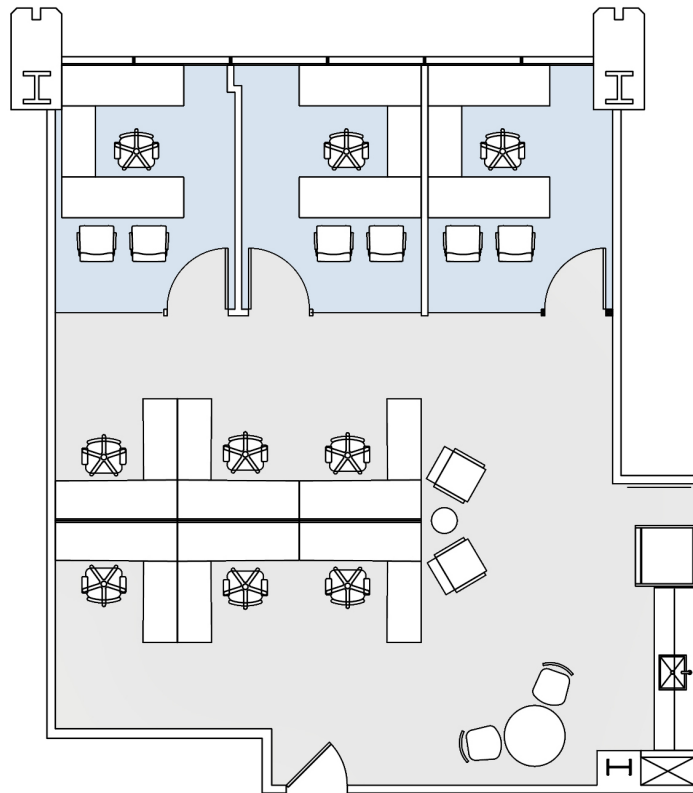

AS-BUILT CONFIGURATION

OFFICES:	3
RECEPTION:	1
OPEN KITCHEN :	1

NOT TO SCALE
FURNITURE NOT INCLUDED

For more information, please contact:

310.255.7777

leasing@douglasemmett.com

**Douglas
Emmett**