
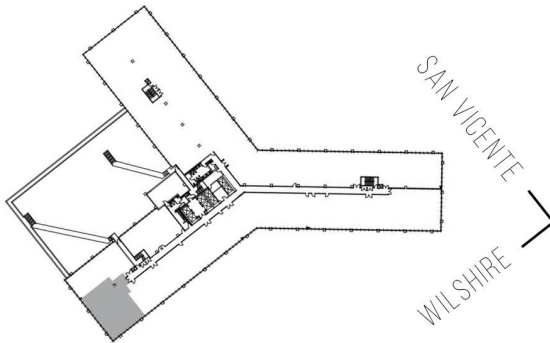


8383
WILSHIRE

SUITE 210 | 2,658 RSF
BEVERLY HILLS

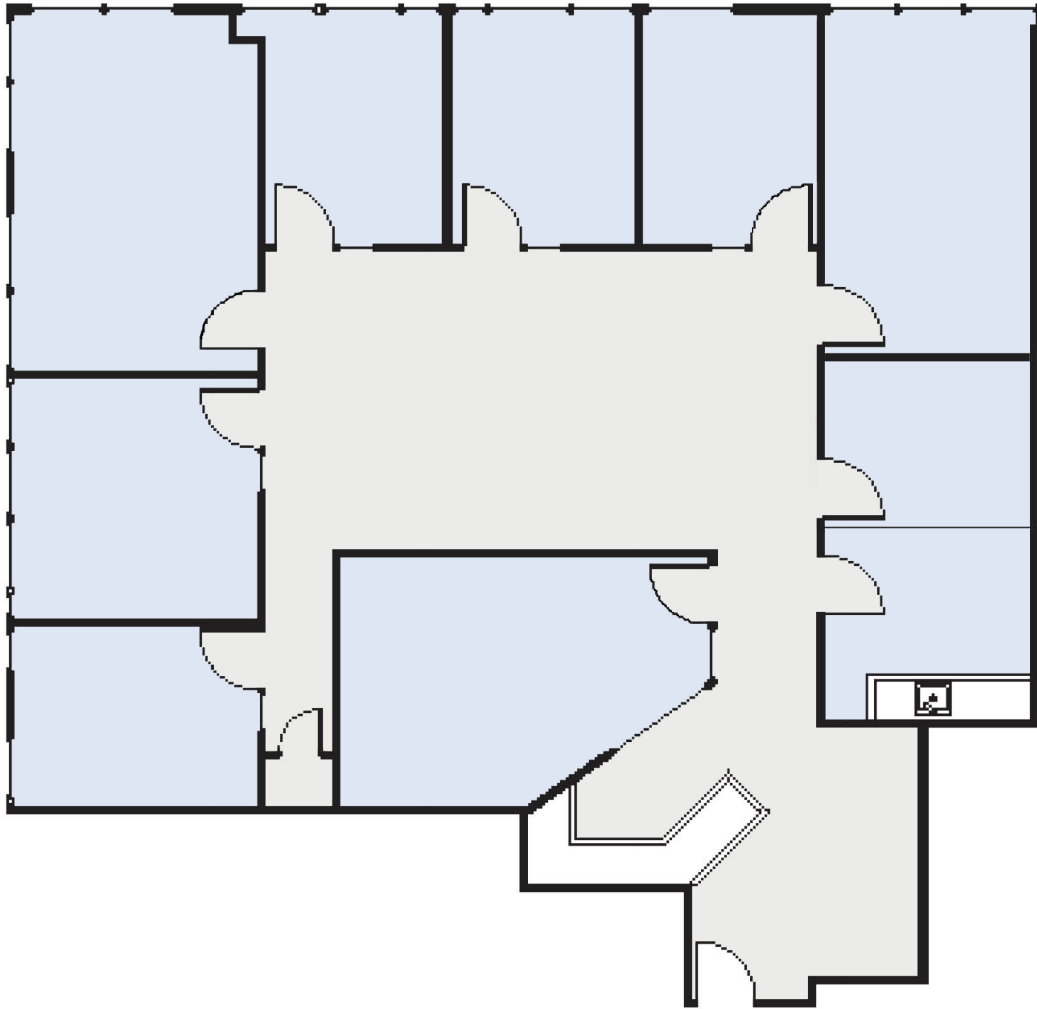

AS-BUILT CONFIGURATION

WINDOW OFFICES:	7
INTERIOR OFFICE:	1
CONFERENCE ROOM:	1
RECEPTION AREA:	1
KITCHEN:	1
SERVER ROOM:	1

NOT TO SCALE
FURNITURE NOT INCLUDED

For more information, please contact:

310.255.7777
leasing@douglasemmett.com

