



# 1801

CENTURY PARK PLAZA

SUITE 1901 | 2,750 RSF

CENTURY CITY

## CENTURY PARK EAST

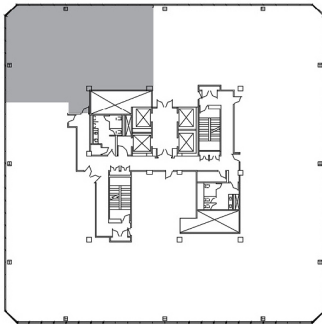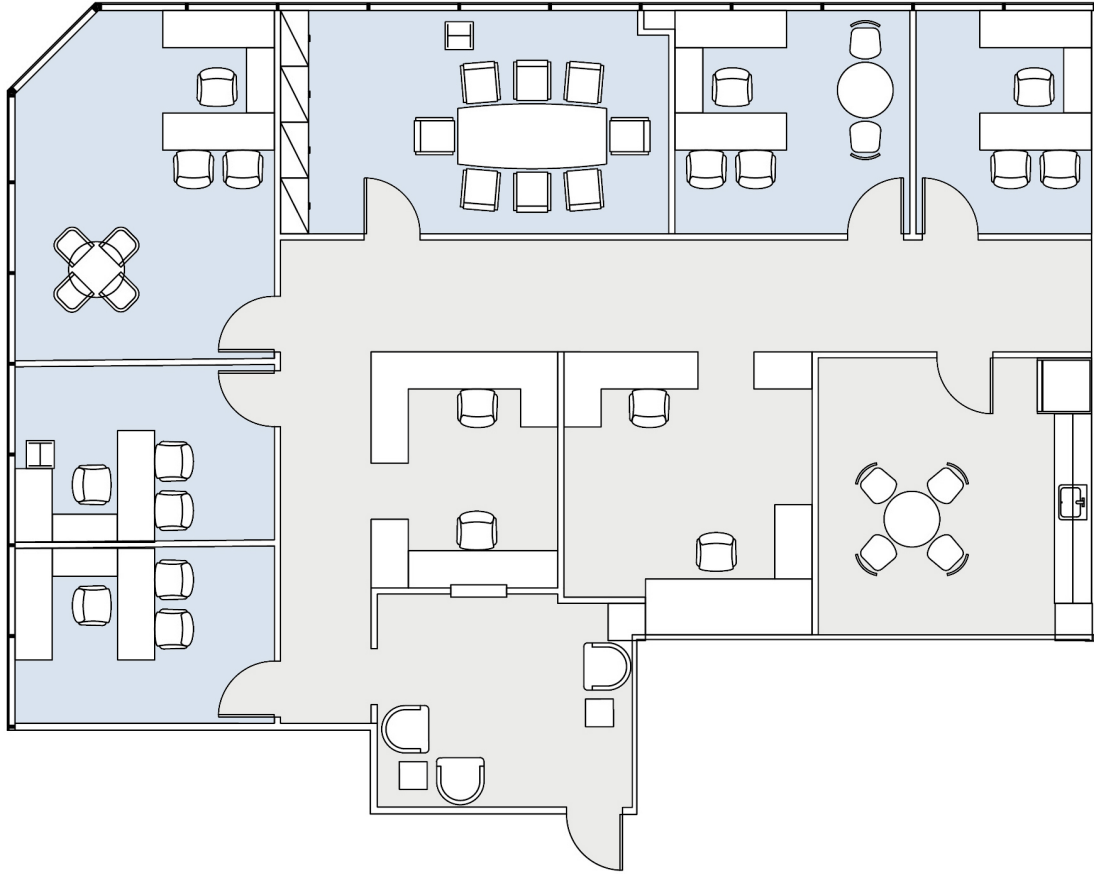

SANTA MONICA BLVD  
CENTURY PARK EAST

### AS-BUILT CONFIGURATION

OFFICES:	5
CONFERENCE ROOM:	1
RECEPTION:	1
KITCHEN:	1

NOT TO SCALE  
FURNITURE NOT INCLUDED

For more information, please contact:

310.255.7777

leasing@douglasemmett.com

**Douglas  
Emmett**