


1333

SECOND STREET PLAZA

SUITE 200 | 15,146 RSF

SANTA MONICA

2ND STREET

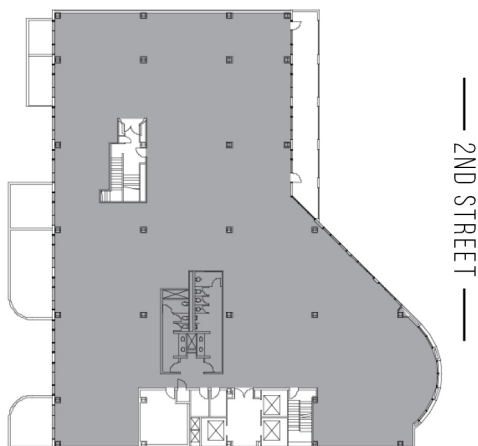

AS-BUILT CONFIGURATION

OFFICES:	11
CONFERENCE ROOMS:	2
RECEPTION:	1
KITCHEN:	1
SEWER ROOM:	1
RESTROOMS:	2
STORAGE CLOSETS:	2

ADJUSTED FOR SOCIAL DISTANCING  
NOT TO SCALE  
FURNITURE NOT INCLUDED

For more information, please contact:

310.255.7777  
leasing@douglasemmett.com

**Douglas  
Emmett**