
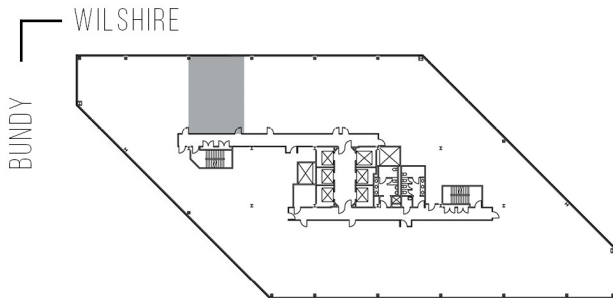


# 12121 WILSHIRE

WILSHIRE BUNDY PLAZA

SUITE 520 | 1,130 RSF

BRENTWOOD-WILSHIRE

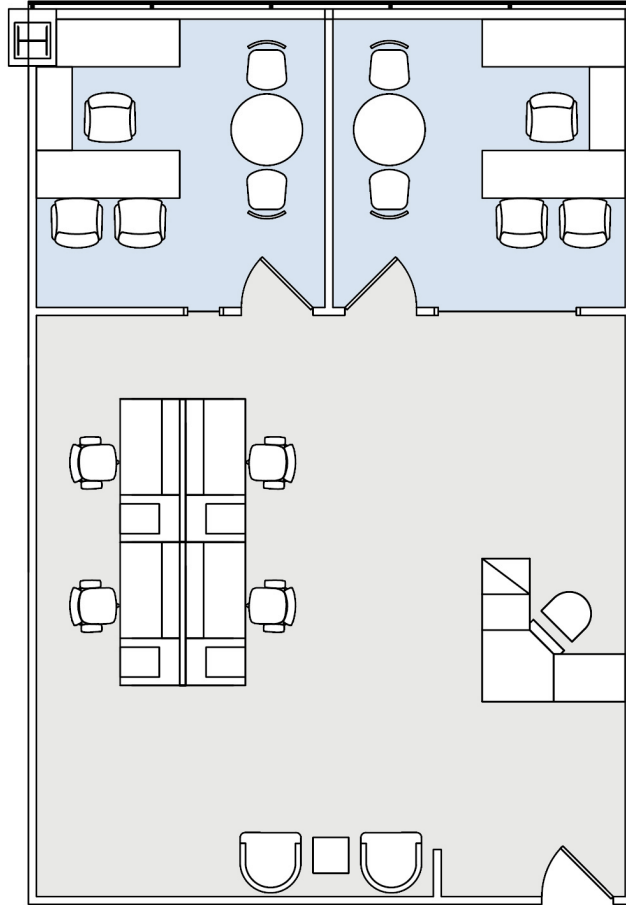

### AS-BUILT CONFIGURATION

OFFICES:	2
RECEPTION AREA:	1

NOT TO SCALE  
FURNITURE NOT INCLUDED

For more information, please contact:

310.255.7777  
leasing@douglasemmett.com

**Douglas  
Emmett**