
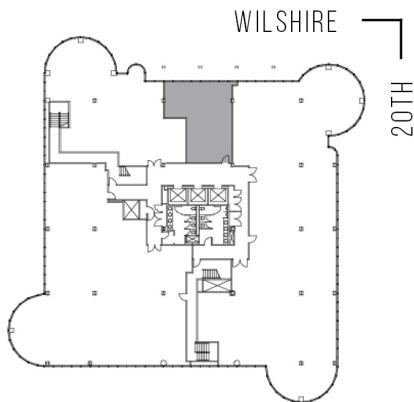


2001 WILSHIRE

SUITE 220 | 1,054 RSF

SANTA MONICA

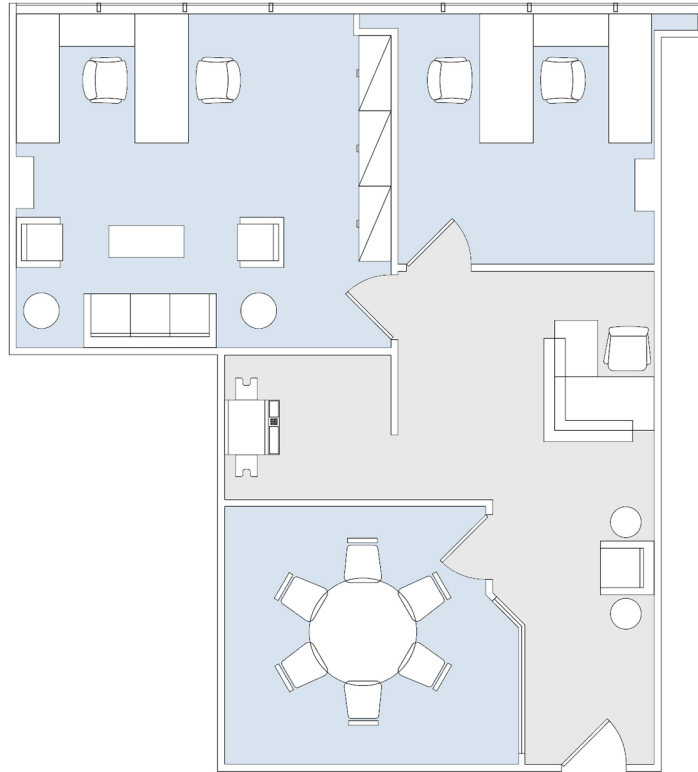

AS-BUILT CONFIGURATION

OFFICES:	2
CONFERENCE ROOM:	1
RECEPTION:	1

ADJUSTED FOR SOCIAL DISTANCING
NOT TO SCALE
FURNITURE NOT INCLUDED

For more information, please contact:

310.255.7777

leasing@douglasemmett.com

**Douglas
Emmett**