
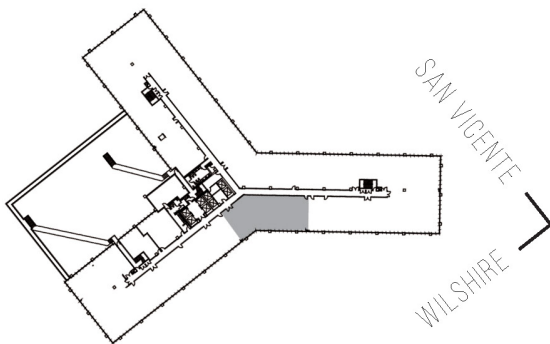


8383
WILSHIRE

SUITE 220 | 3,293 RSF
BEVERLY HILLS

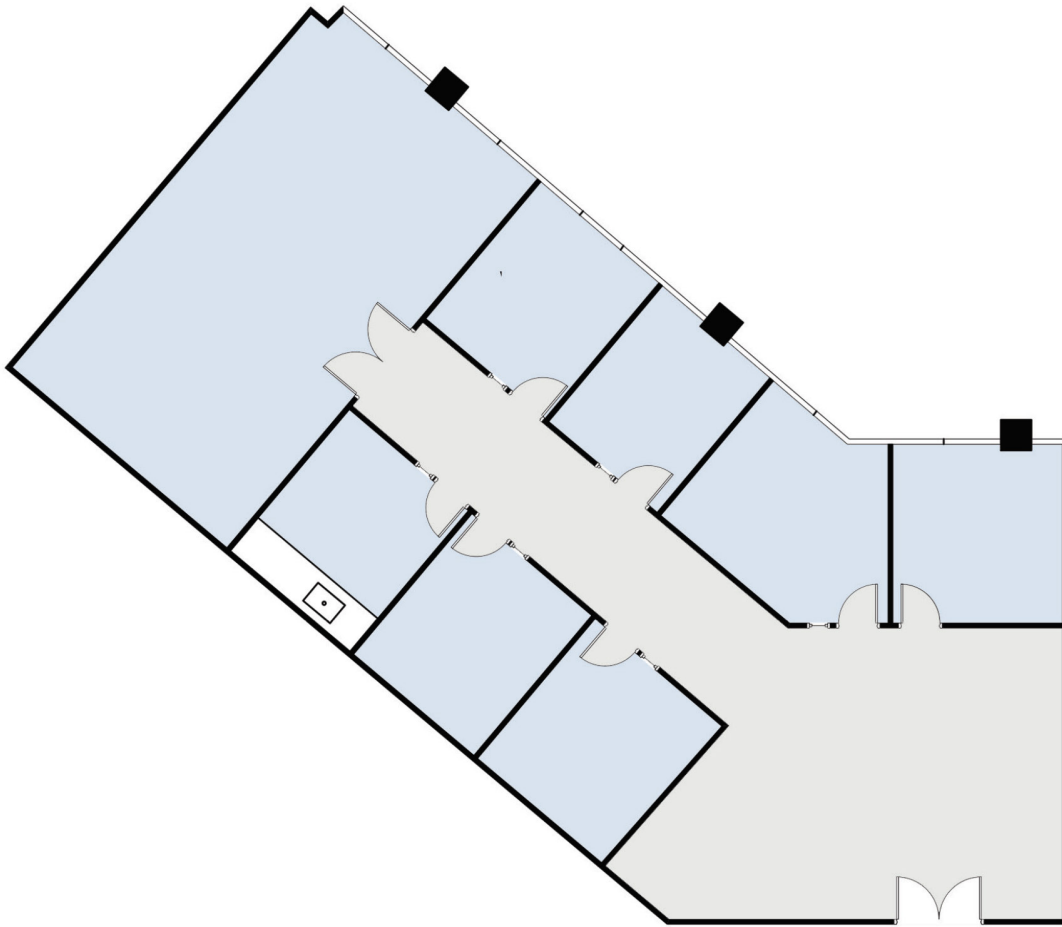

AS-BUILT CONFIGURATION

OFFICES:	6
KITCHEN:	1
RECEPTION AREA:	1

NOT TO SCALE
FURNITURE NOT INCLUDED

For more information, please contact:

310.255.7777
leasing@douglasemmett.com

