
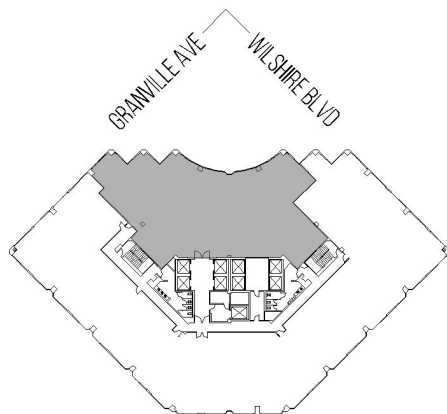


11766 WILSHIRE

LANDMARK II

SUITE 800 | 7,273 RSF

BRENTWOOD-WILSHIRE

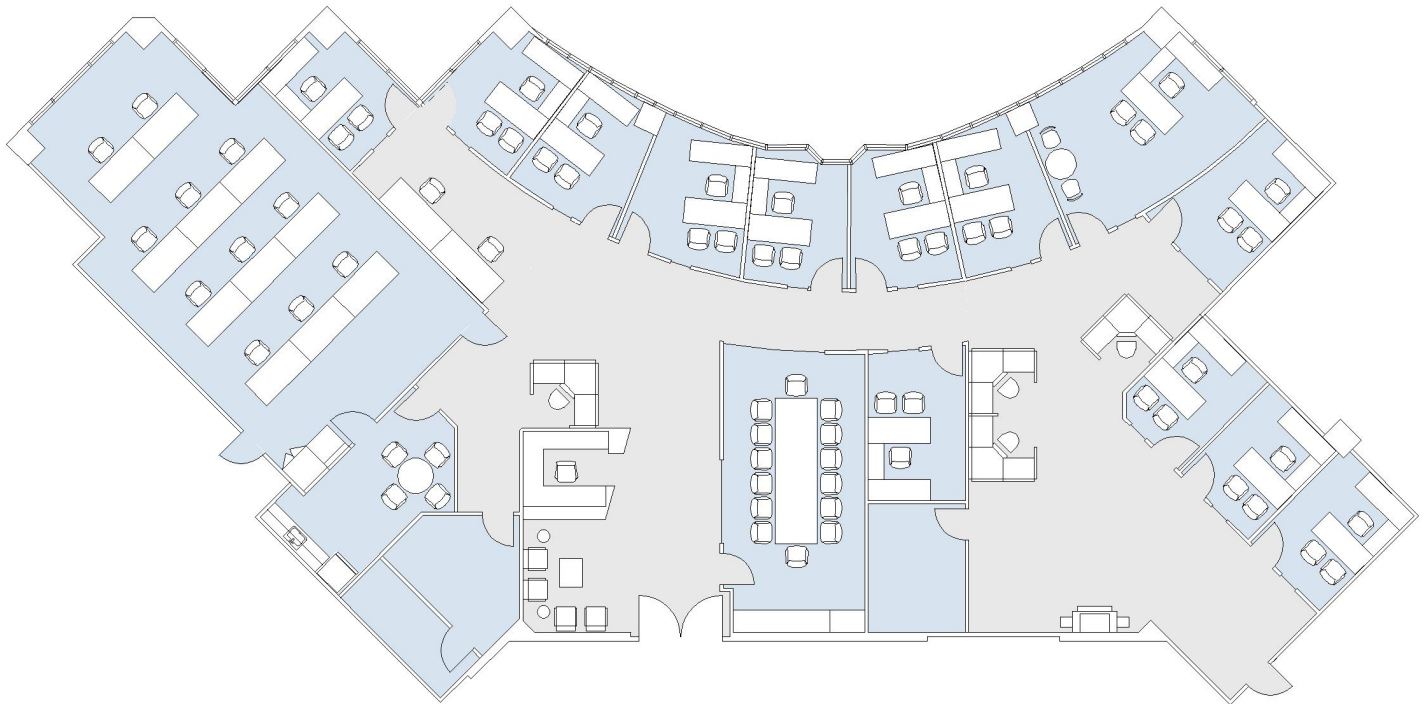

AS-BUILT CONFIGURATION

OFFICES:	13
CONFERENCE ROOM:	2
RECEPTION:	1
KITCHEN:	1
STORAGE:	2

NOT TO SCALE
FURNITURE NOT INCLUDED

For more information, please contact:

310.255.7777

leasing@douglasemmett.com

**Douglas
Emmett**