


11835 OLYMPIC

WESTSIDE TOWERS EAST TOWER

SUITE 700 | 8,234 RSF

SAWTELLE/WEST LA

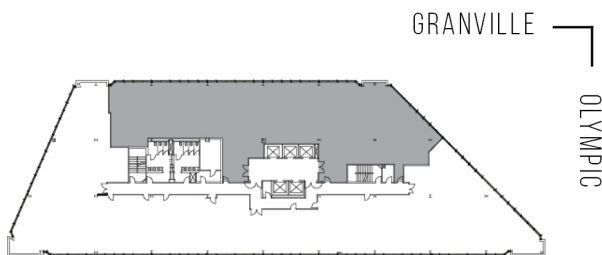

AS-BUILT CONFIGURATION

OFFICES:	21
CONFERENCE ROOMS:	3
RECEPTION:	1
STORAGE ROOM:	1
FILE ROOM:	1
I.T. ROOM:	1
KITCHEN:	1
COPY ROOM:	1

ADJUSTED FOR SOCIAL DISTANCING
NOT TO SCALE
FURNITURE NOT INCLUDED

For more information, please contact:

310.255.7777
leasing@douglasemmett.com

**Douglas
Emmett**