
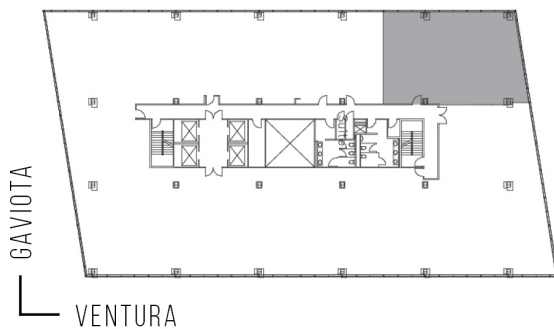


16000 VENTURA

SUITE 910 | 2,042 RSF
SHERMAN OAKS/ENCINO

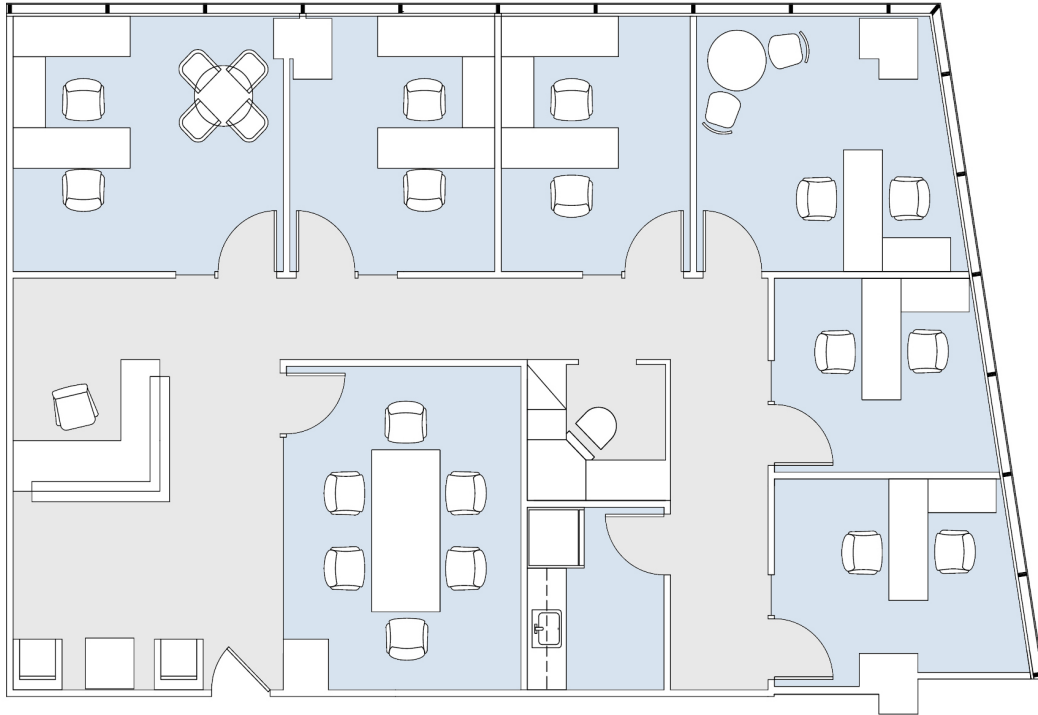

AS-BUILT CONFIGURATION

OFFICES:	6
CONFERENCE ROOM:	1
RECEPTION:	1
KITCHEN:	1

ADJUSTED FOR SOCIAL DISTANCING
NOT TO SCALE
FURNITURE NOT INCLUDED

For more information, please contact:

310.255.7777
leasing@douglasemmett.com

**Douglas
Emmett**