
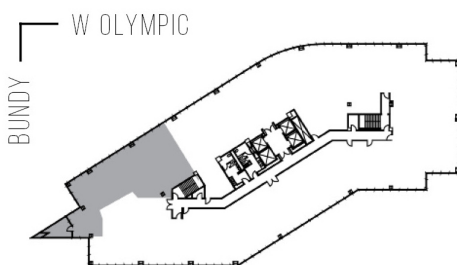


# 11900 OLYMPIC

BUNDY/OLYMPIC

SUITE 490 | 3,247 RSF

SAWTELLE/WEST LA

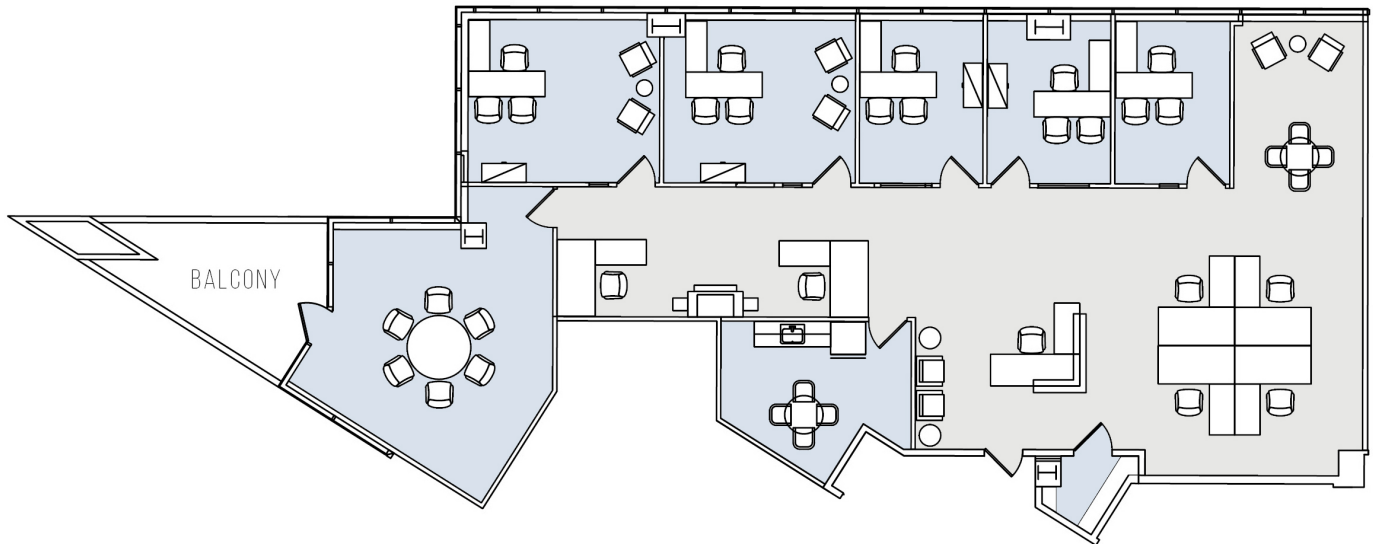

#### AS-BUILT CONFIGURATION

WINDOW OFFICES:	5
CONFERENCE ROOM:	1
KITCHEN:	2
STORAGE:	1
RECEPTION:	1

NOT TO SCALE  
FURNITURE NOT INCLUDED

For more information, please contact:

310.255.7777

leasing@douglasemmett.com

**Douglas  
Emmett**