
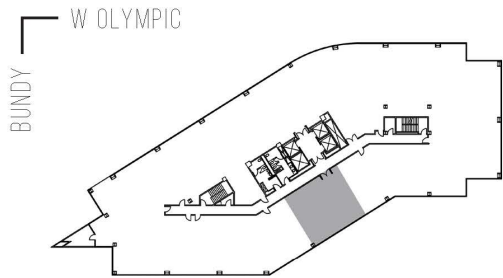


11900 OLYMPIC

BUNDY/OLYMPIC

SUITE 550 | 1,392 RSF

SAWTELLE/WEST LA

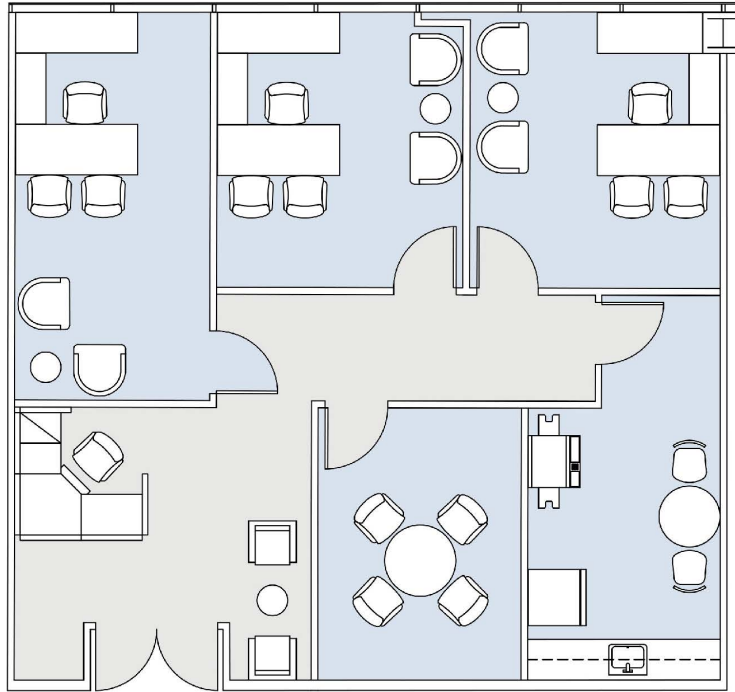

AS-BUILT CONFIGURATION

OFFICES:	3
WORKSTATION:	1
CONFERENCE ROOM:	1
KITCHEN:	1

NOT TO SCALE
FURNITURE NOT INCLUDED

For more information, please contact:

310.255.7777

leasing@douglasemmett.com

**Douglas
Emmett**