


# 401 WILSHIRE

SUITE 220 | 1,190 RSF

SANTA MONICA

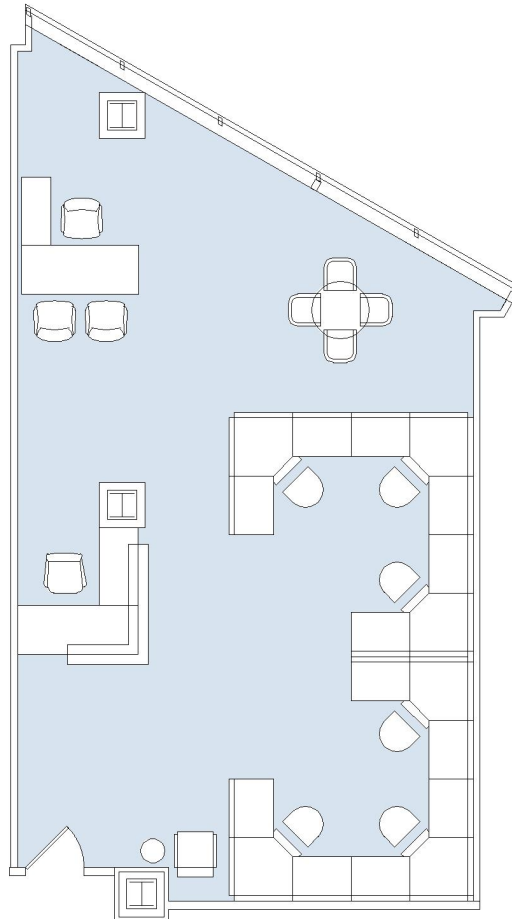


AS-BUILT CONFIGURATION

OPEN SPACE

NOT TO SCALE

FURNITURE NOT INCLUDED

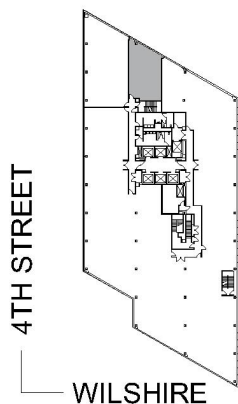

For more information, please contact:

310.255.7777  
leasing@douglasemmett.com

**Douglas  
Emmett**