
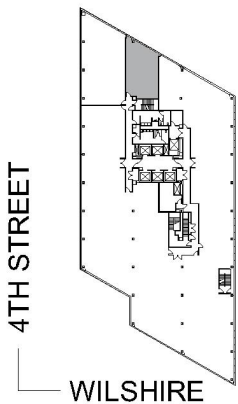


401 WILSHIRE

SUITE 220 | 1,190 RSF
SANTA MONICA

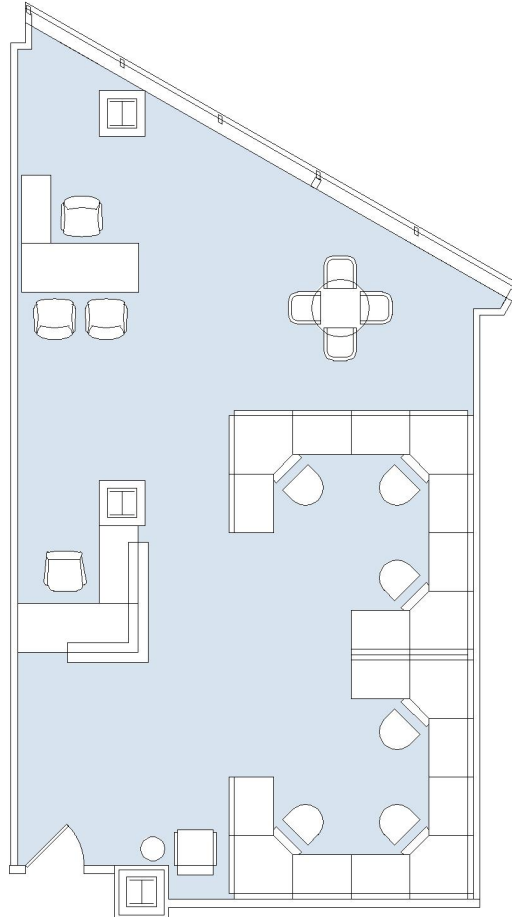

AS-BUILT CONFIGURATION

OPEN SPACE

NOT TO SCALE

FURNITURE NOT INCLUDED

For more information, please contact:

310.255.7777
leasing@douglasemmett.com

**Douglas
Emmett**