
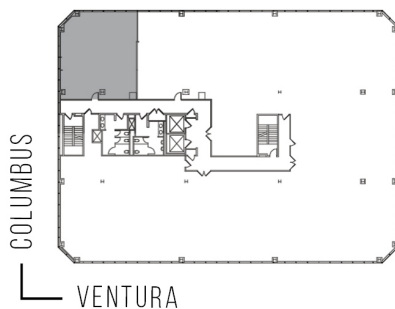


# 15165 VENTURA

COLUMBUS CENTER

SUITE 310 | 1,617 RSF

SHERMAN OAKS/ENCINO

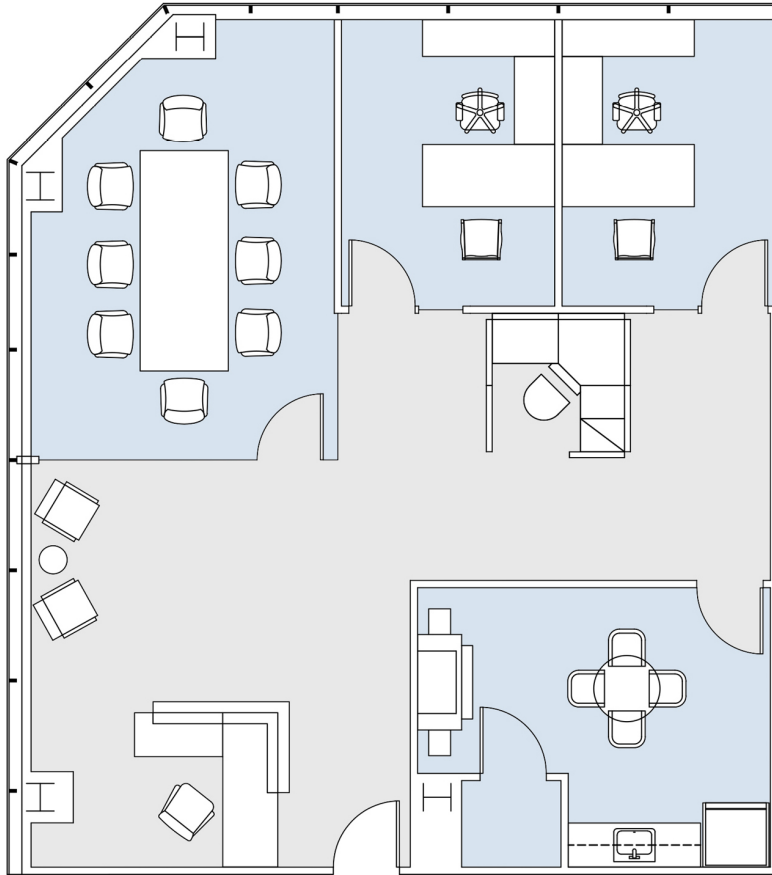

#### AS-BUILT CONFIGURATION

OFFICES:	2
CONFERENCE ROOM:	1
RECEPTION:	1
KITCHEN:	1
STORAGE CLOSET:	1

ADJUSTED FOR SOCIAL DISTANCING  
NOT TO SCALE  
FURNITURE NOT INCLUDED

For more information, please contact:

310.255.7777

leasing@douglasemmett.com

**Douglas  
Emmett**