
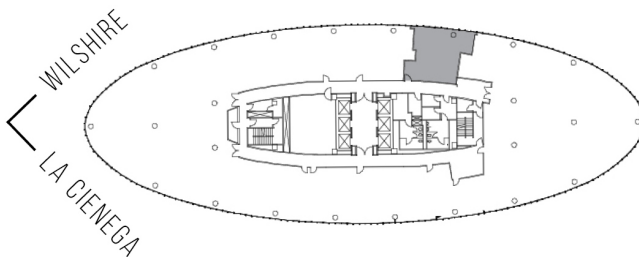


# 8484 WILSHIRE

SUITE 210 | 930 RSF  
BEVERLY HILLS

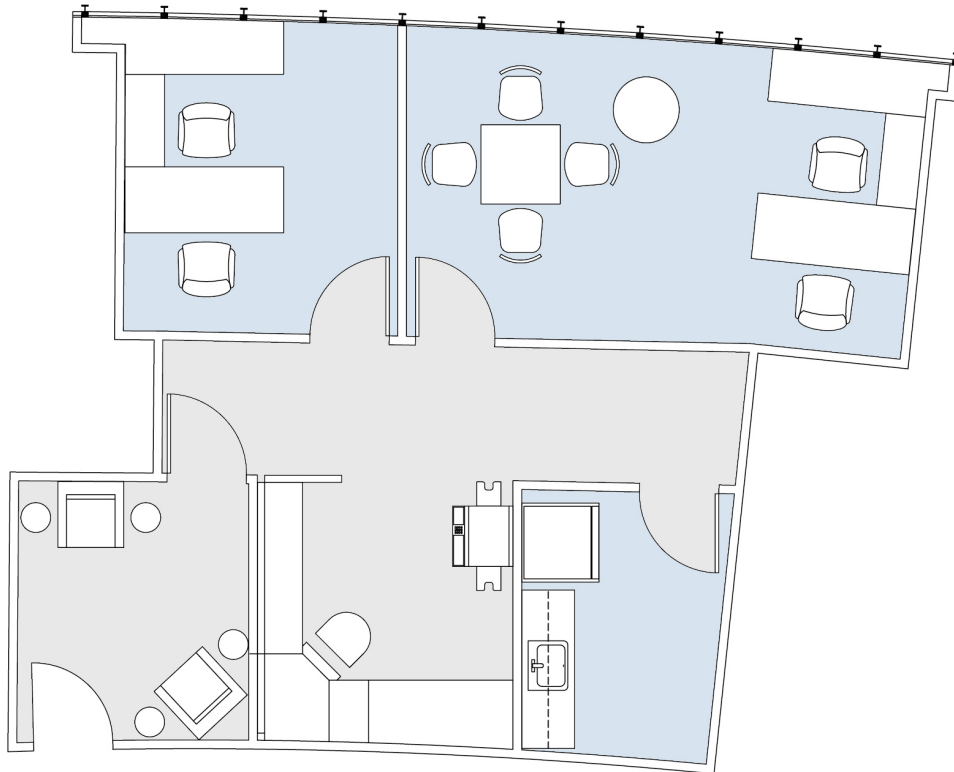

#### AS-BUILT CONFIGURATION

OPEN OFFICE:	2
RECEPTION:	1
KITCHEN:	1

ADJUSTED FOR SOCIAL DISTANCING  
NOT TO SCALE  
FURNITURE NOT INCLUDED

For more information, please contact:

310.255.7777  
leasing@douglasemmett.com

**Douglas  
Emmett**