


# 11835 OLYMPIC

WESTSIDE TOWERS EAST TOWER

SUITE 145 | 1,401 RSF

SAWTELLE/WEST LA

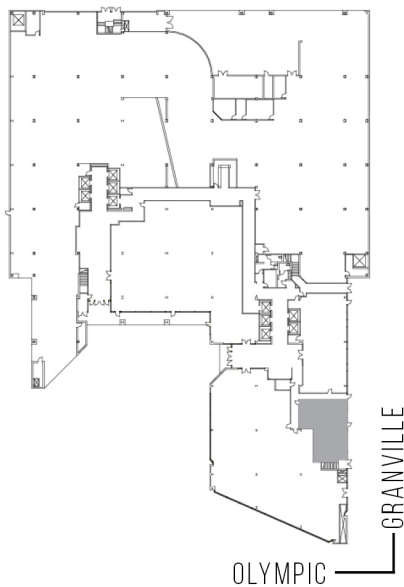

#### AS-BUILT CONFIGURATION

OFFICES:	3
RECEPTION AREA:	1
STORAGE ROOM:	1

NOT TO SCALE  
FURNITURE NOT INCLUDED

For more information, please contact:

310.255.7777

leasing@douglasemmett.com

**Douglas  
Emmett**