
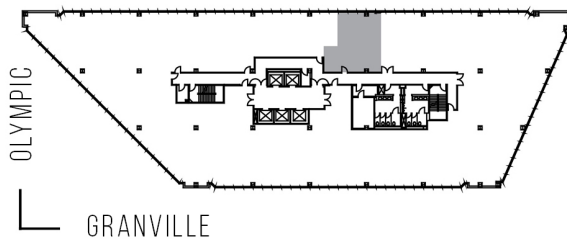


11835 OLYMPIC

WESTSIDE TOWERS EAST TOWER

SUITE 1055 | 1,013 RSF

SAWTELLE/WEST LA

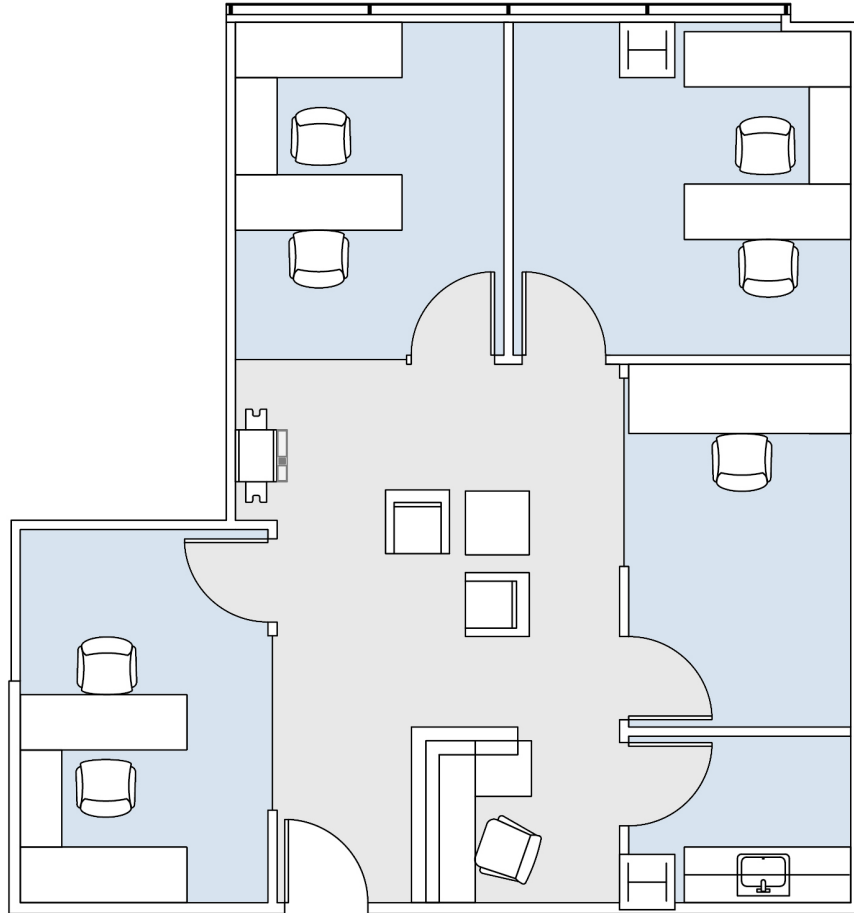

AS-BUILT CONFIGURATION

OFFICES:	4
KITCHEN:	1
RECEPTION:	1

ADJUSTED FOR SOCIAL DISTANCING

NOT TO SCALE
FURNITURE NOT INCLUDED

For more information, please contact:

310.255.7777

leasing@douglasemmett.com

**Douglas
Emmett**