



1990

CORNERSTONE PLAZA

SUITE 340 | 7,961 RSF

SAWTELLE/WEST LA

SOUTH BUNDY

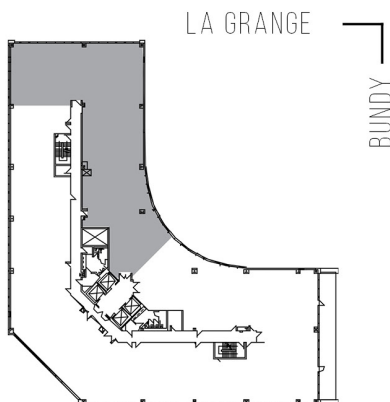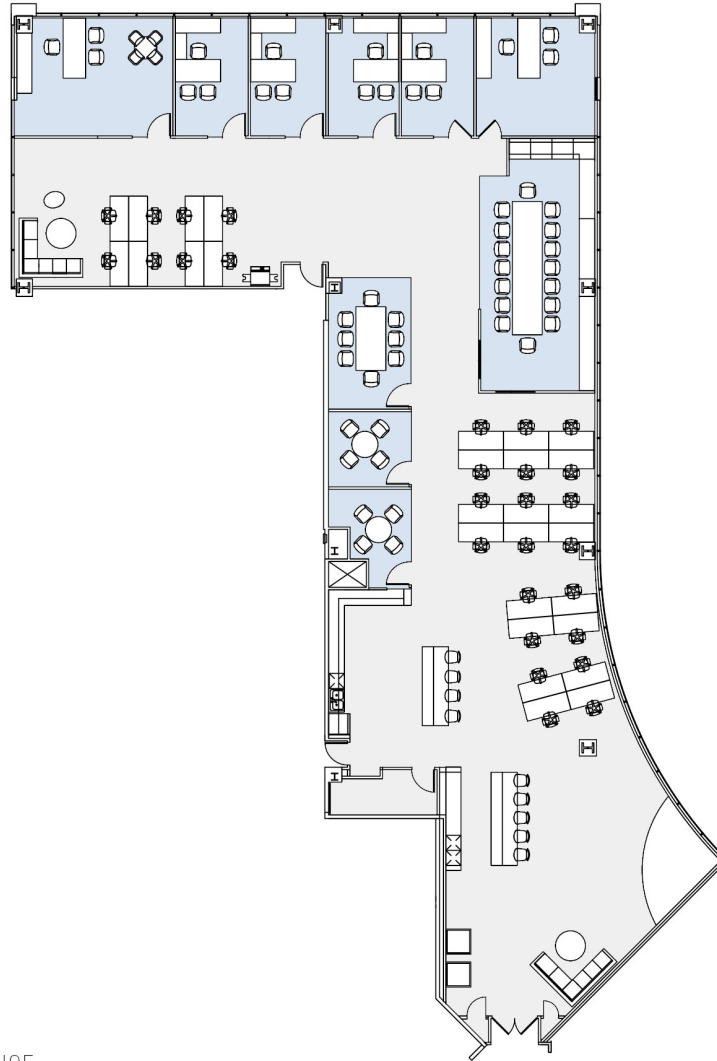

AS-BUILT CONFIGURATION

OFFICES:	6
CONFERENCE ROOMS:	2
BREAK OUT ROOMS:	2
RECEPTION:	1
OPEN KITCHEN:	1
IT CLOSET:	1
STORAGE CLOSETS:	2

NOT TO SCALE
FURNITURE NOT INCLUDED

For more information, please contact:

310.255.7777

leasing@douglasemmett.com

**Douglas
Emmett**