
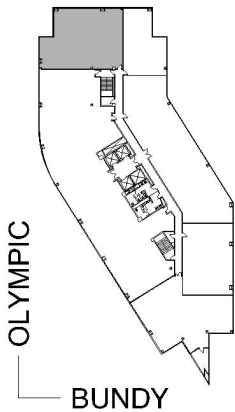


11900 OLYMPIC

BUNDY/OLYMPIC

SUITE 720 | 2,671 RSF

SAWTELLE/WEST LA

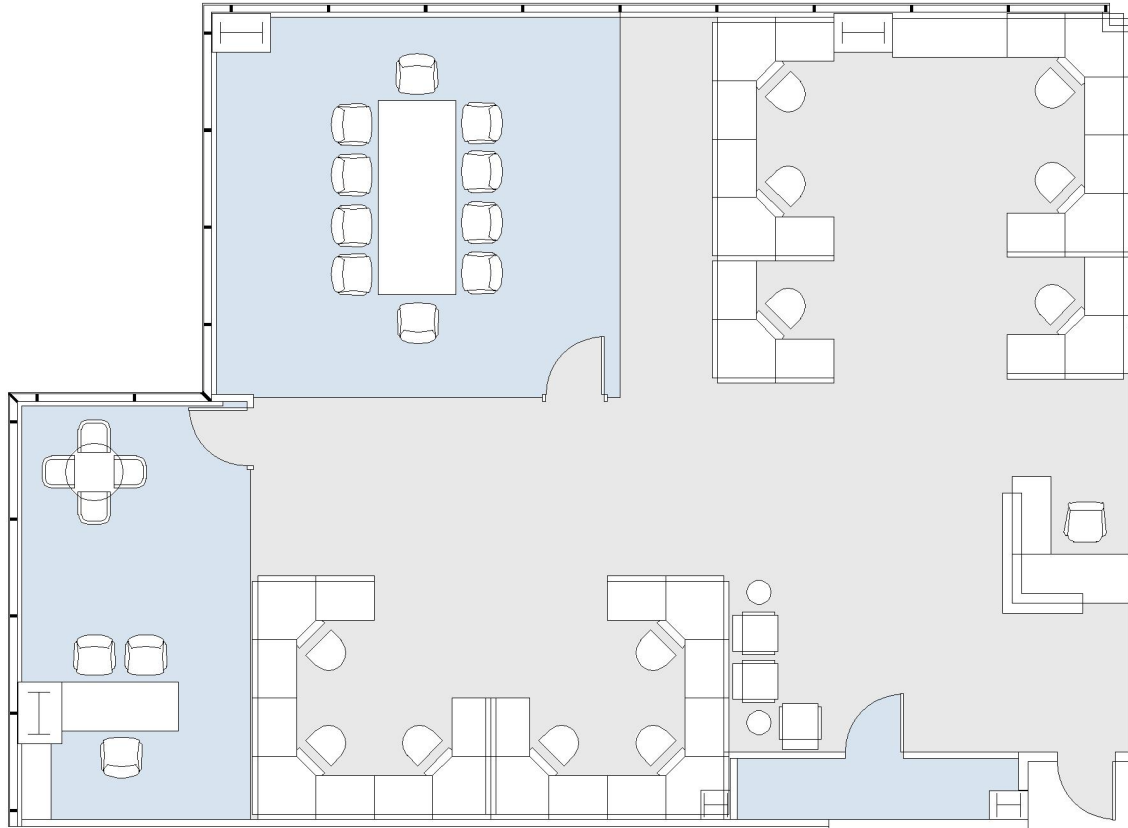

AS-BUILT CONFIGURATION

OFFICES:	1
CONFERENCE ROOM:	1
RECEPTION:	1
STORAGE:	1

NOT TO SCALE

FURNITURE NOT INCLUDED

For more information, please contact:

310.255.7777

leasing@douglasemmett.com

**Douglas
Emmett**