


# 12011

SALTAIR/SAN VICENTE

SUITE 702 | 1,063 RSF

BRENTWOOD-SAN VICENTE

## SAN VICENTE

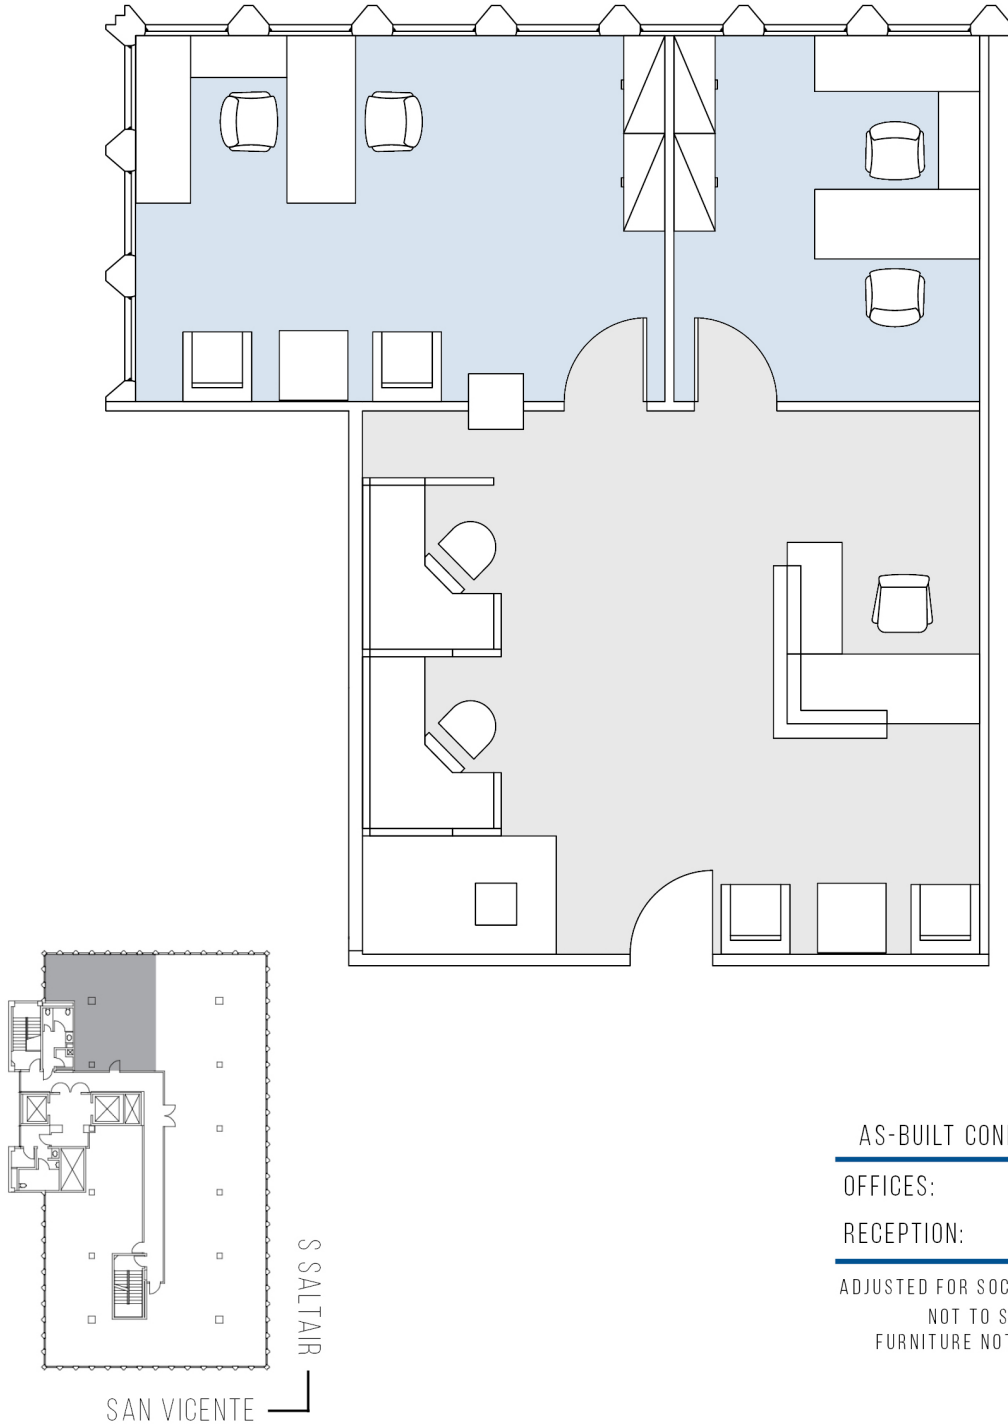

### AS-BUILT CONFIGURATION

OFFICES:	2
RECEPTION:	1

ADJUSTED FOR SOCIAL DISTANCING  
NOT TO SCALE  
FURNITURE NOT INCLUDED

For more information, please contact:

310.255.7777

leasing@douglasemmett.com

**Douglas  
Emmett**