
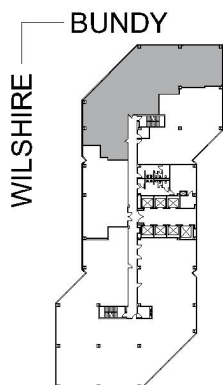


# 12100 WILSHIRE

SUITE 1250 | 5,078 RSF

BRENTWOOD-WILSHIRE

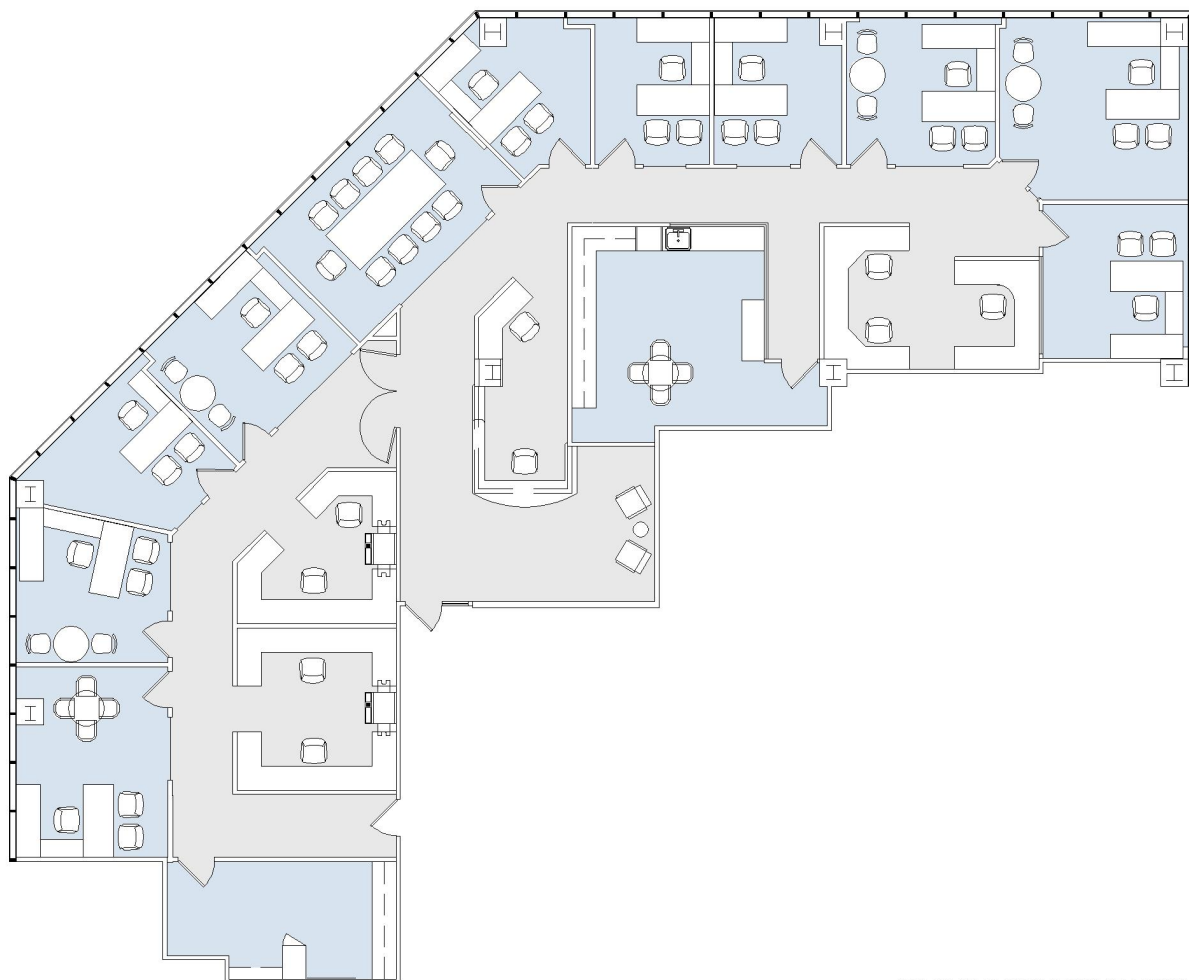

## AS-BUILT CONFIGURATION

OFFICES:	10
CONFERENCE ROOM:	1
RECEPTION:	1
KITCHEN:	1
IT ROOM:	1

NOT TO SCALE

FURNITURE NOT INCLUDED

For more information, please contact:

310.255.7777  
leasing@douglasemmett.com

**Douglas  
Emmett**