
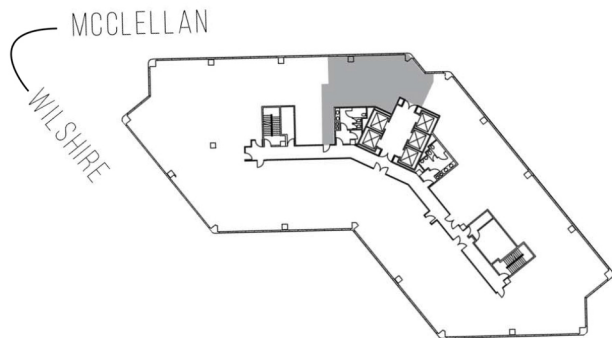


12400 WILSHIRE

SUITE 320 | 1,496 RSF
BRENTWOOD-WILSHIRE

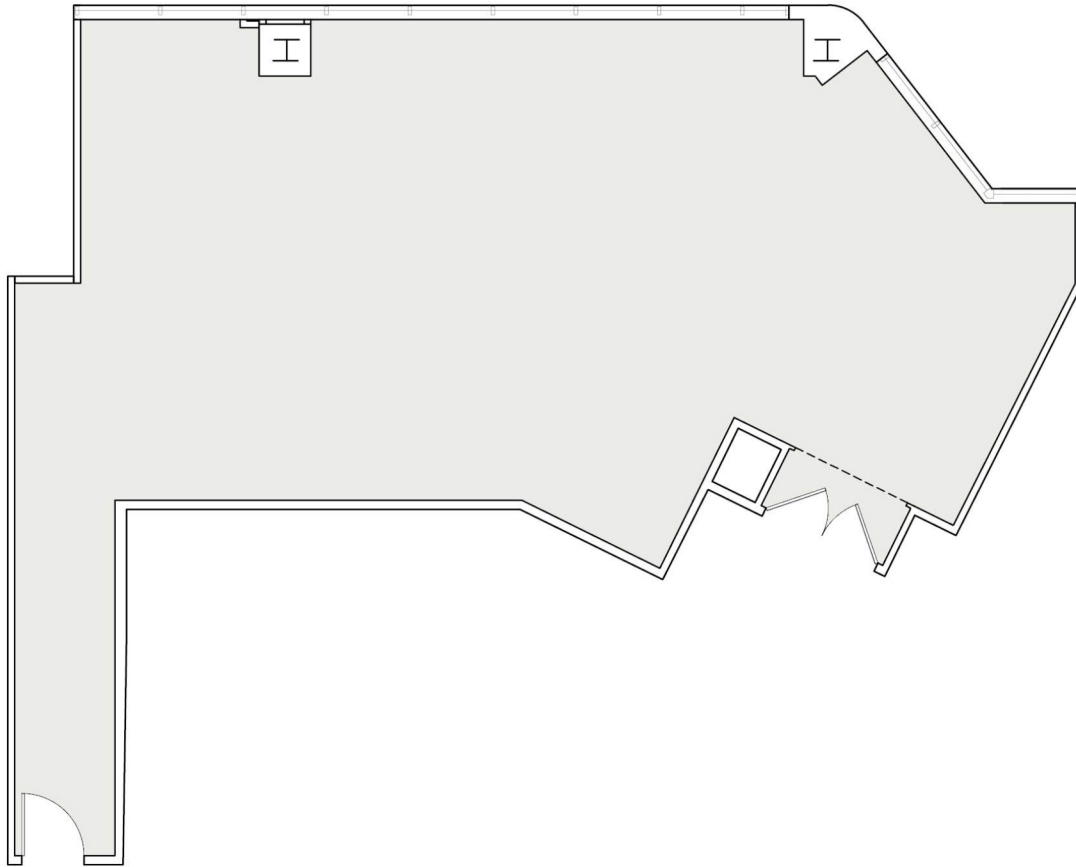

AS-BUILT CONFIGURATION

OPEN SPACE

NOT TO SCALE

For more information, please contact:

310.255.7777
leasing@douglasemmett.com

**Douglas
Emmett**