
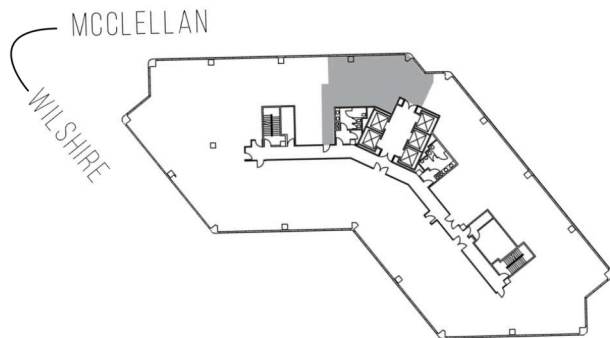


# 12400 WILSHIRE

SUITE 320 | 1,496 RSF  
BRENTWOOD-WILSHIRE

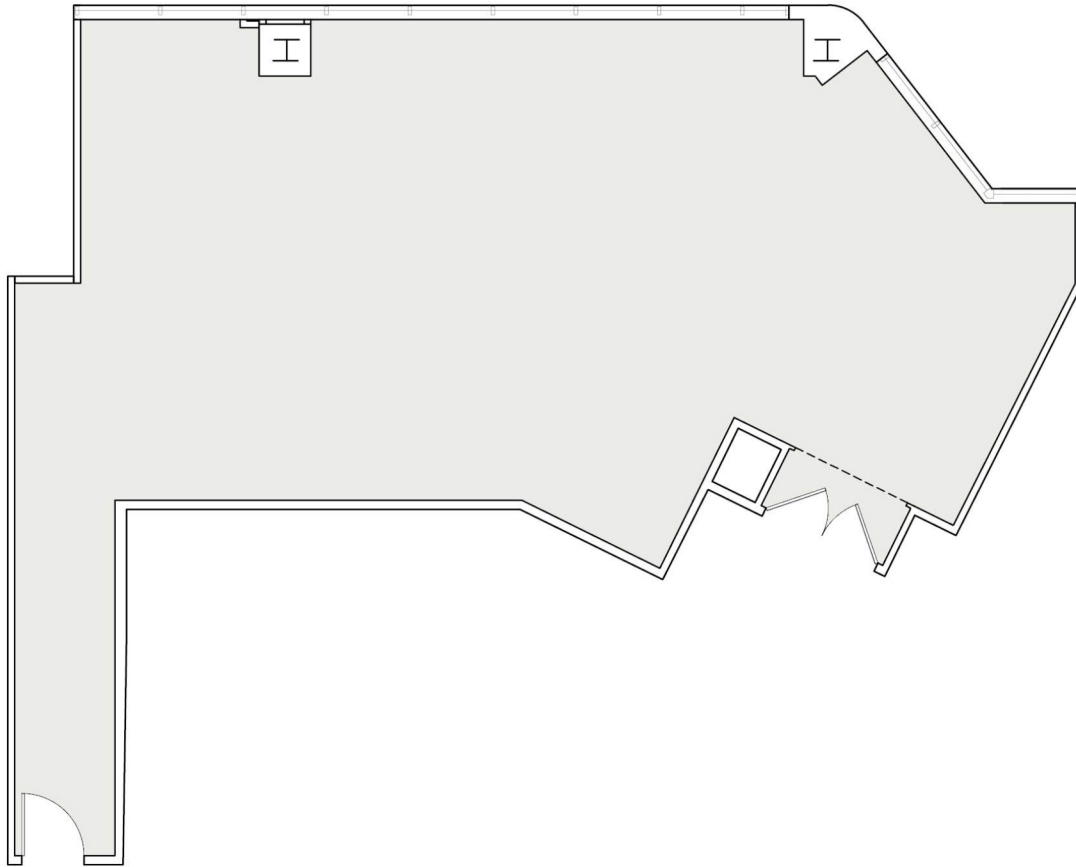

AS-BUILT CONFIGURATION

OPEN SPACE

NOT TO SCALE

For more information, please contact:

310.255.7777

leasing@douglasemmett.com

**Douglas  
Emmett**