


# 12424 WILSHIRE

GATEWAY LOS ANGELES

SUITE 1440 | 1,800 RSF

BRENTWOOD-WILSHIRE

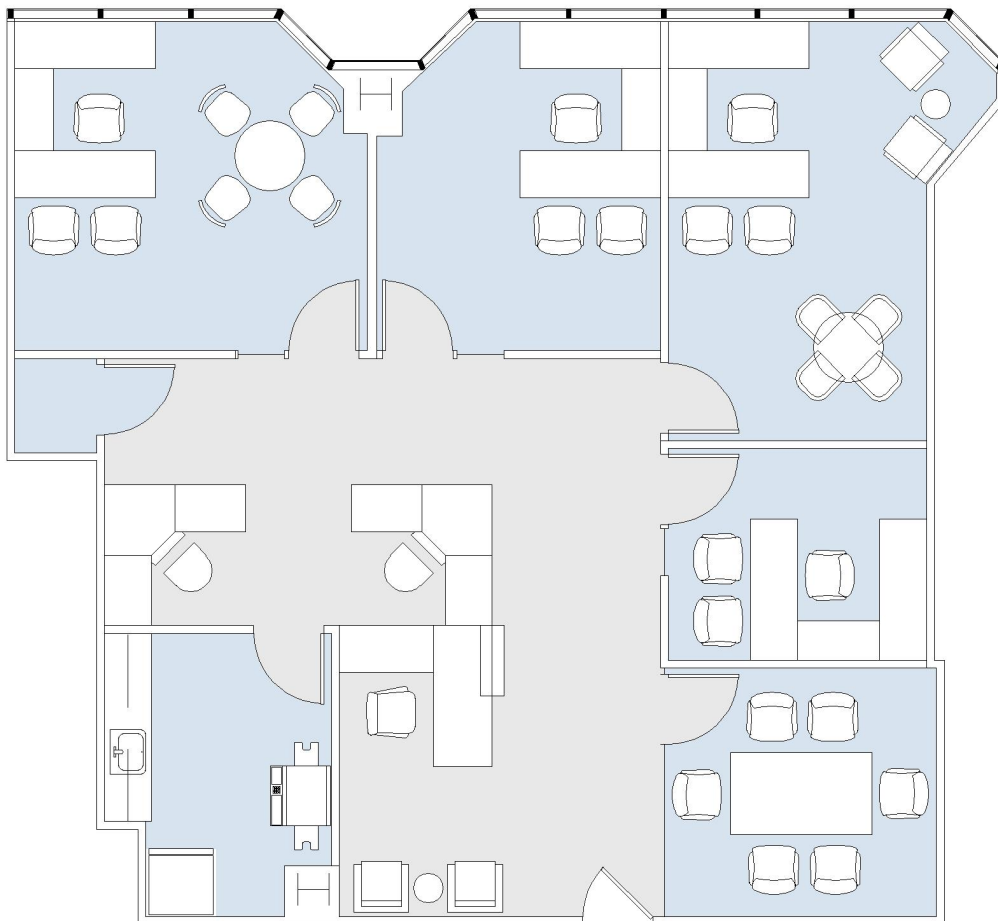


## AS-BUILT CONFIGURATION

OFFICES:	4
CONFERENCE ROOM:	1
RECEPTION:	1
KITCHEN:	1
IT CLOSET:	1

NOT TO SCALE

FURNITURE NOT INCLUDED

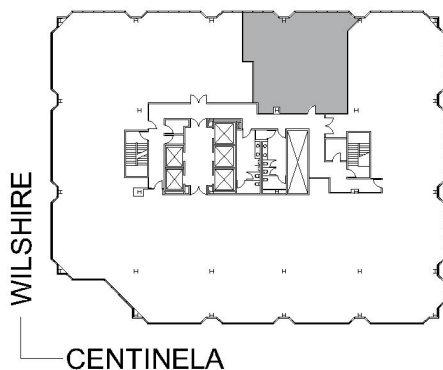

For more information, please contact:

310.255.7777

leasing@douglasemmett.com

**Douglas  
Emmett**