
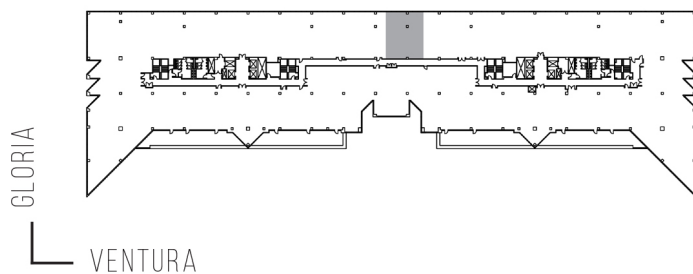


15821
VENTURA

ENCINO TERRACE

SUITE 445 | 1,981 RSF

SHERMAN OAKS/ENCINO

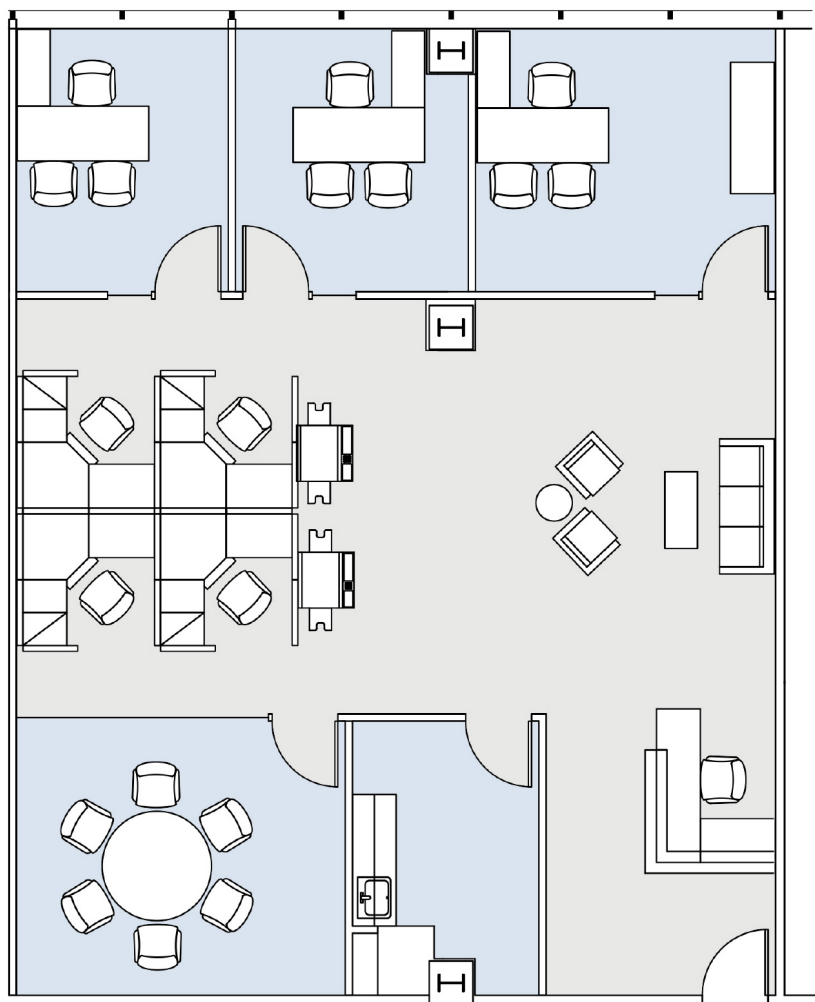

AS-BUILT CONFIGURATION

OFFICES:	3
RECEPTION:	1
CONFERENCE ROOM:	1
KITCHEN:	1

NOT TO SCALE
FURNITURE NOT INCLUDED

For more information, please contact:

310.255.7777

leasing@douglasemmett.com

**Douglas
Emmett**