
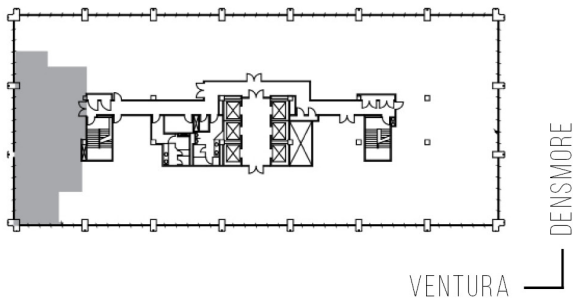


# 15760 VENTURA

ENCINO GATEWAY

SUITE 1010 | 2,309 RSF

SHERMAN OAKS/ENCINO

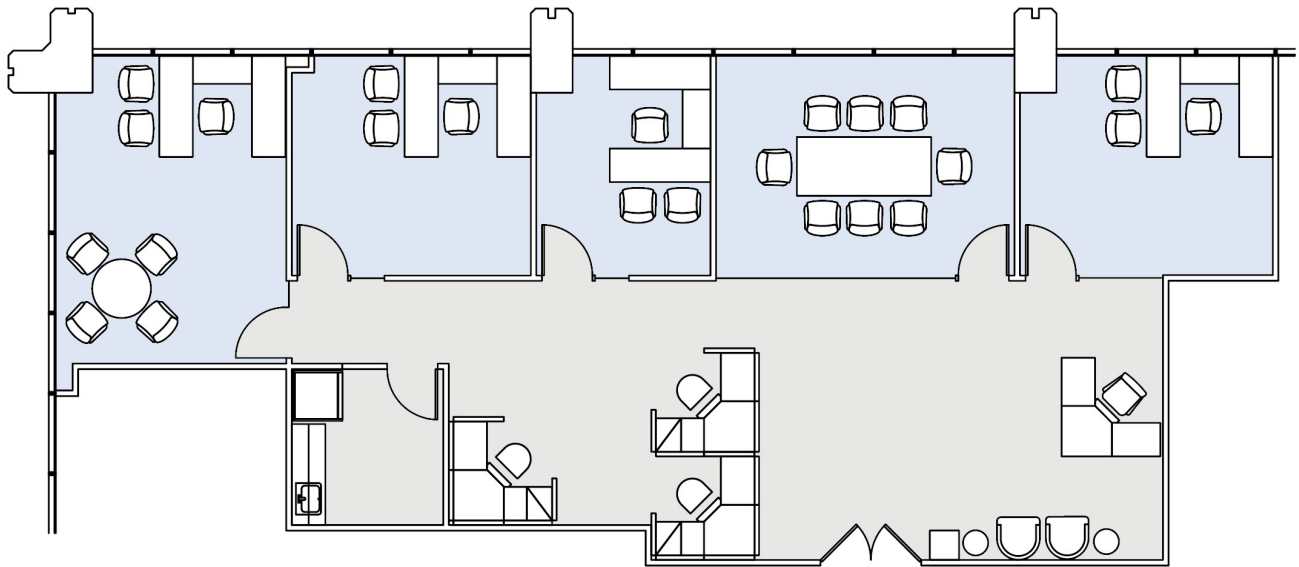

#### AS-BUILT CONFIGURATION

OFFICES:	4
CONFERENCE ROOM:	1
KITCHEN:	1
RECEPTION AREA:	1

NOT TO SCALE  
FURNITURE NOT INCLUDED

For more information, please contact:

310.255.7777  
leasing@douglasemmett.com

**Douglas  
Emmett**